




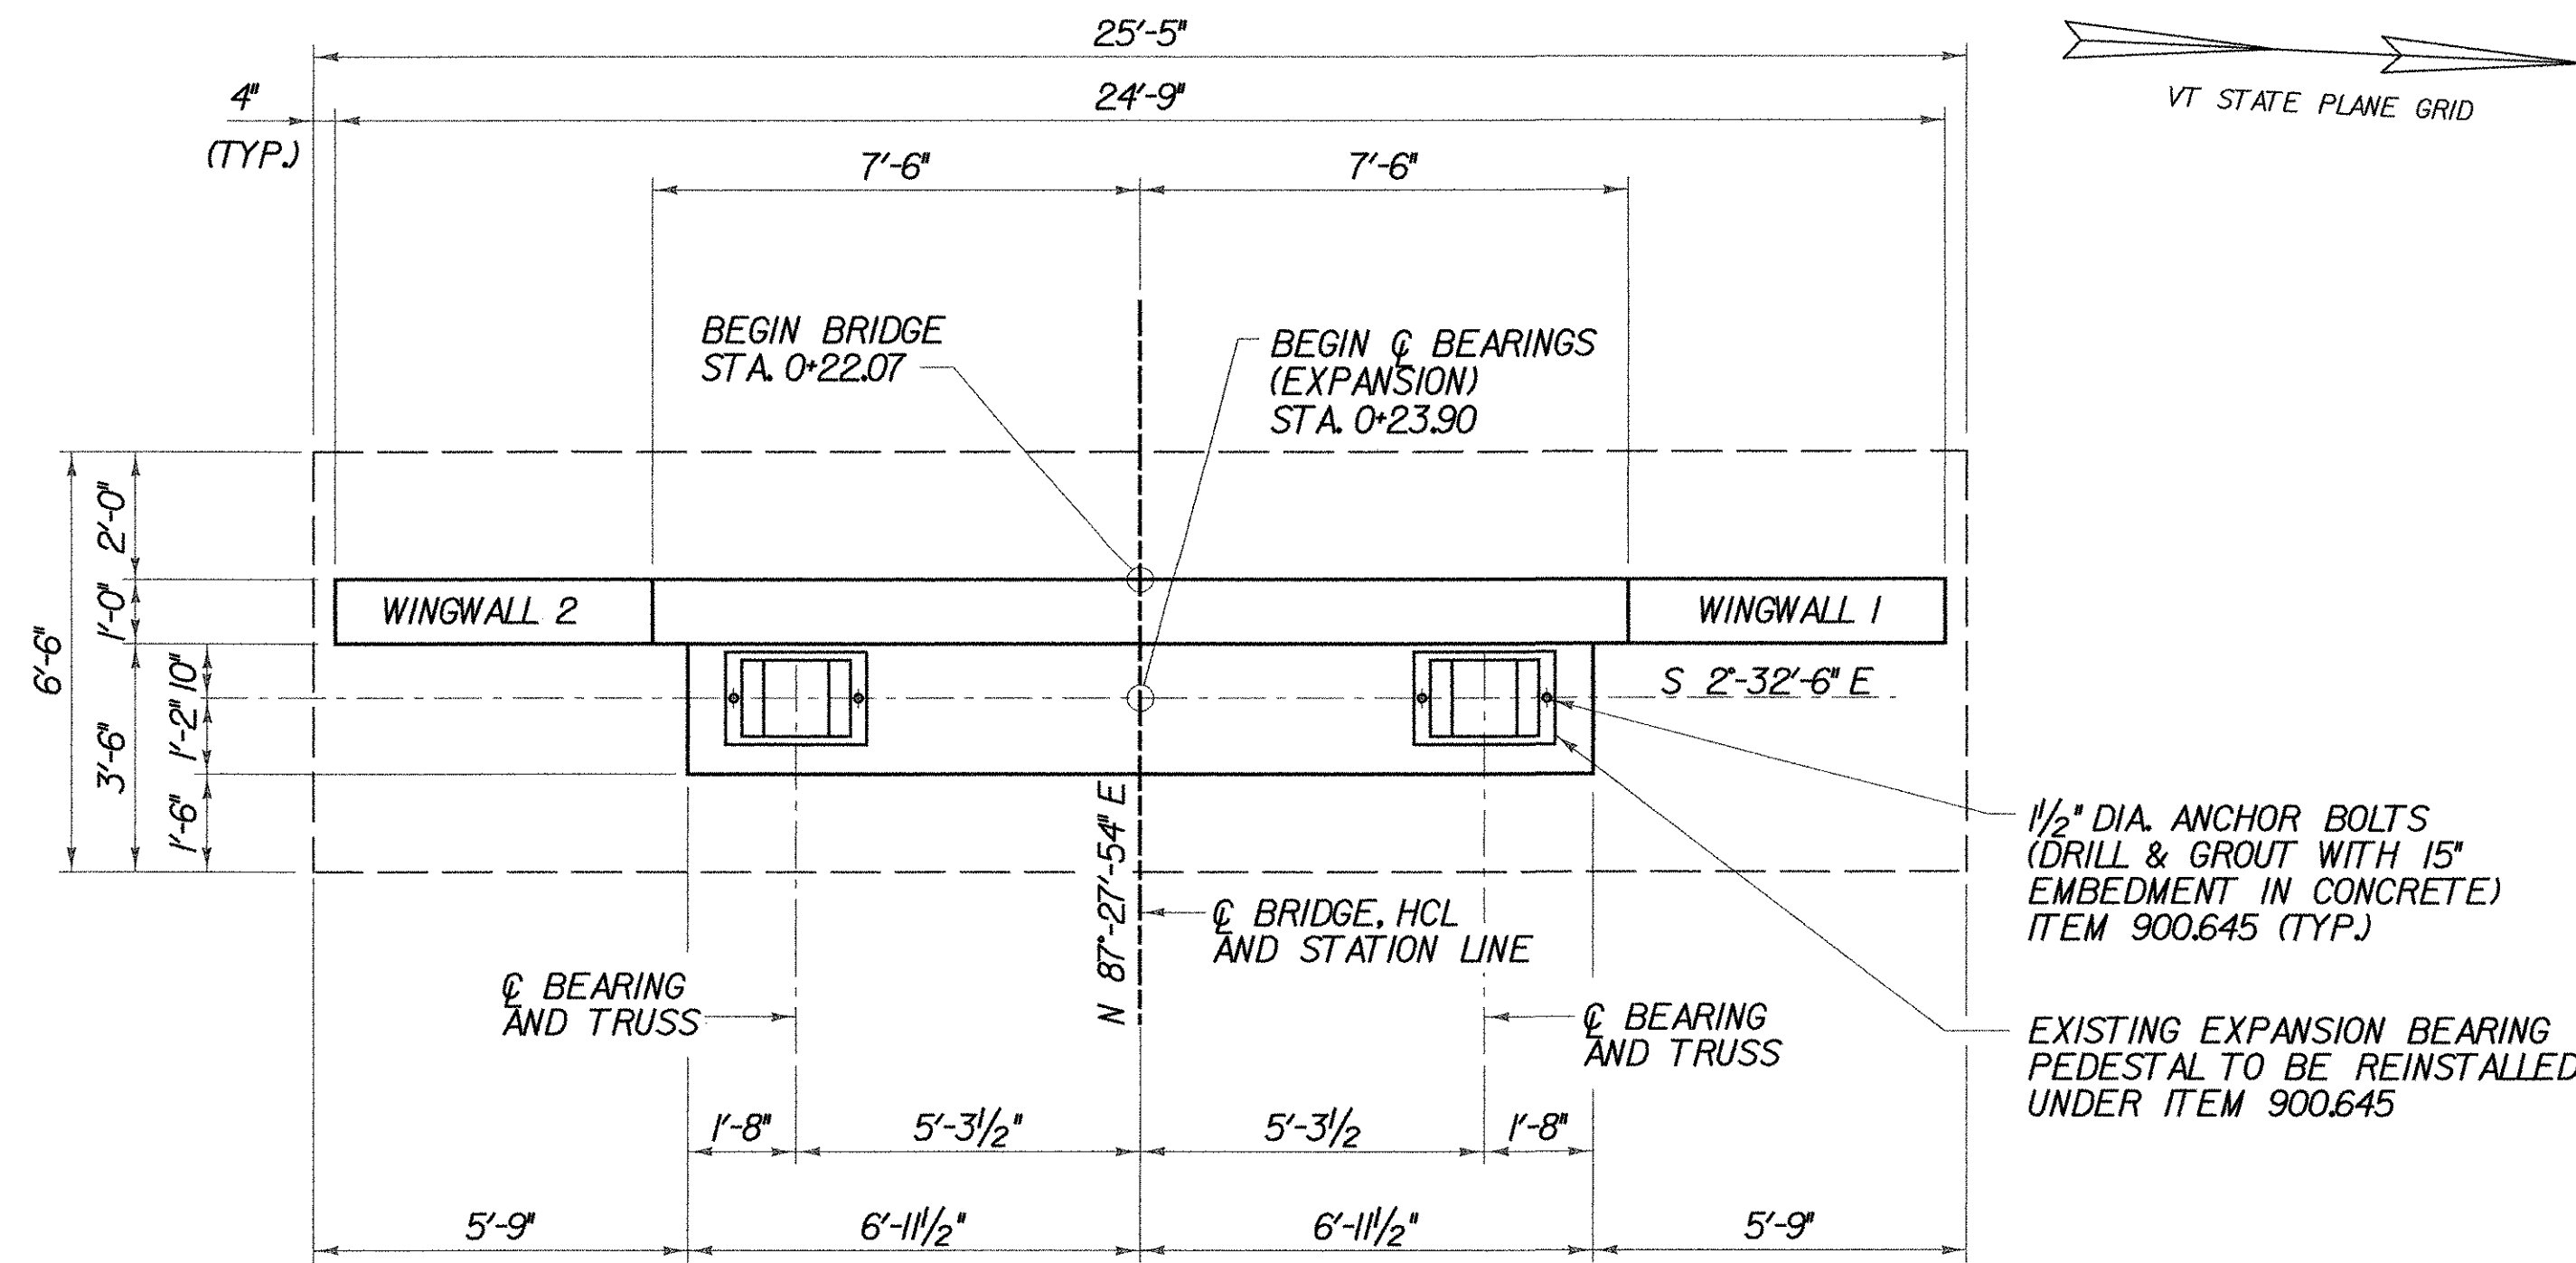

PLAN
SCALE 3/8" = 1'-0"
1 0 1 2 3 4

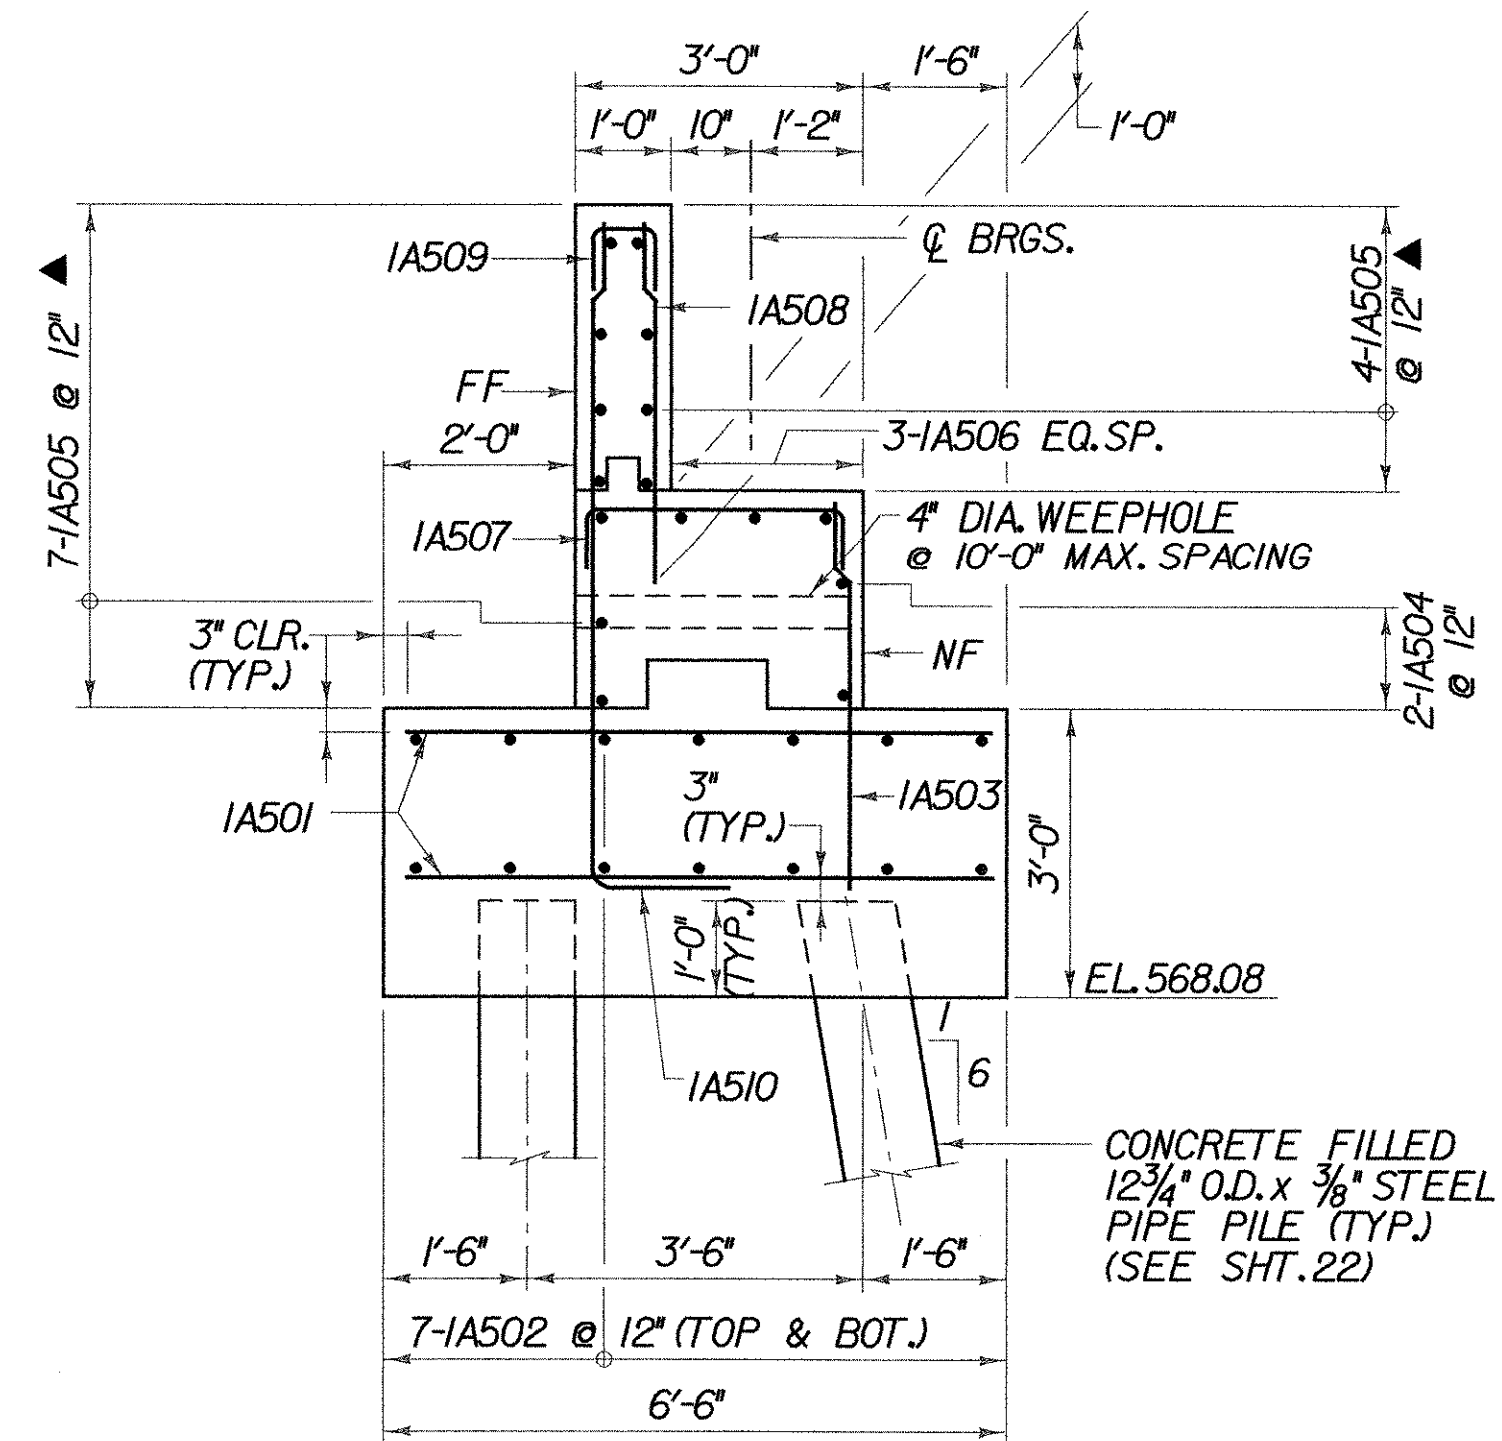


A TYPICAL ABUTMENT SECTION
SCALE 1/2" = 1'-0"
1 0 1 2

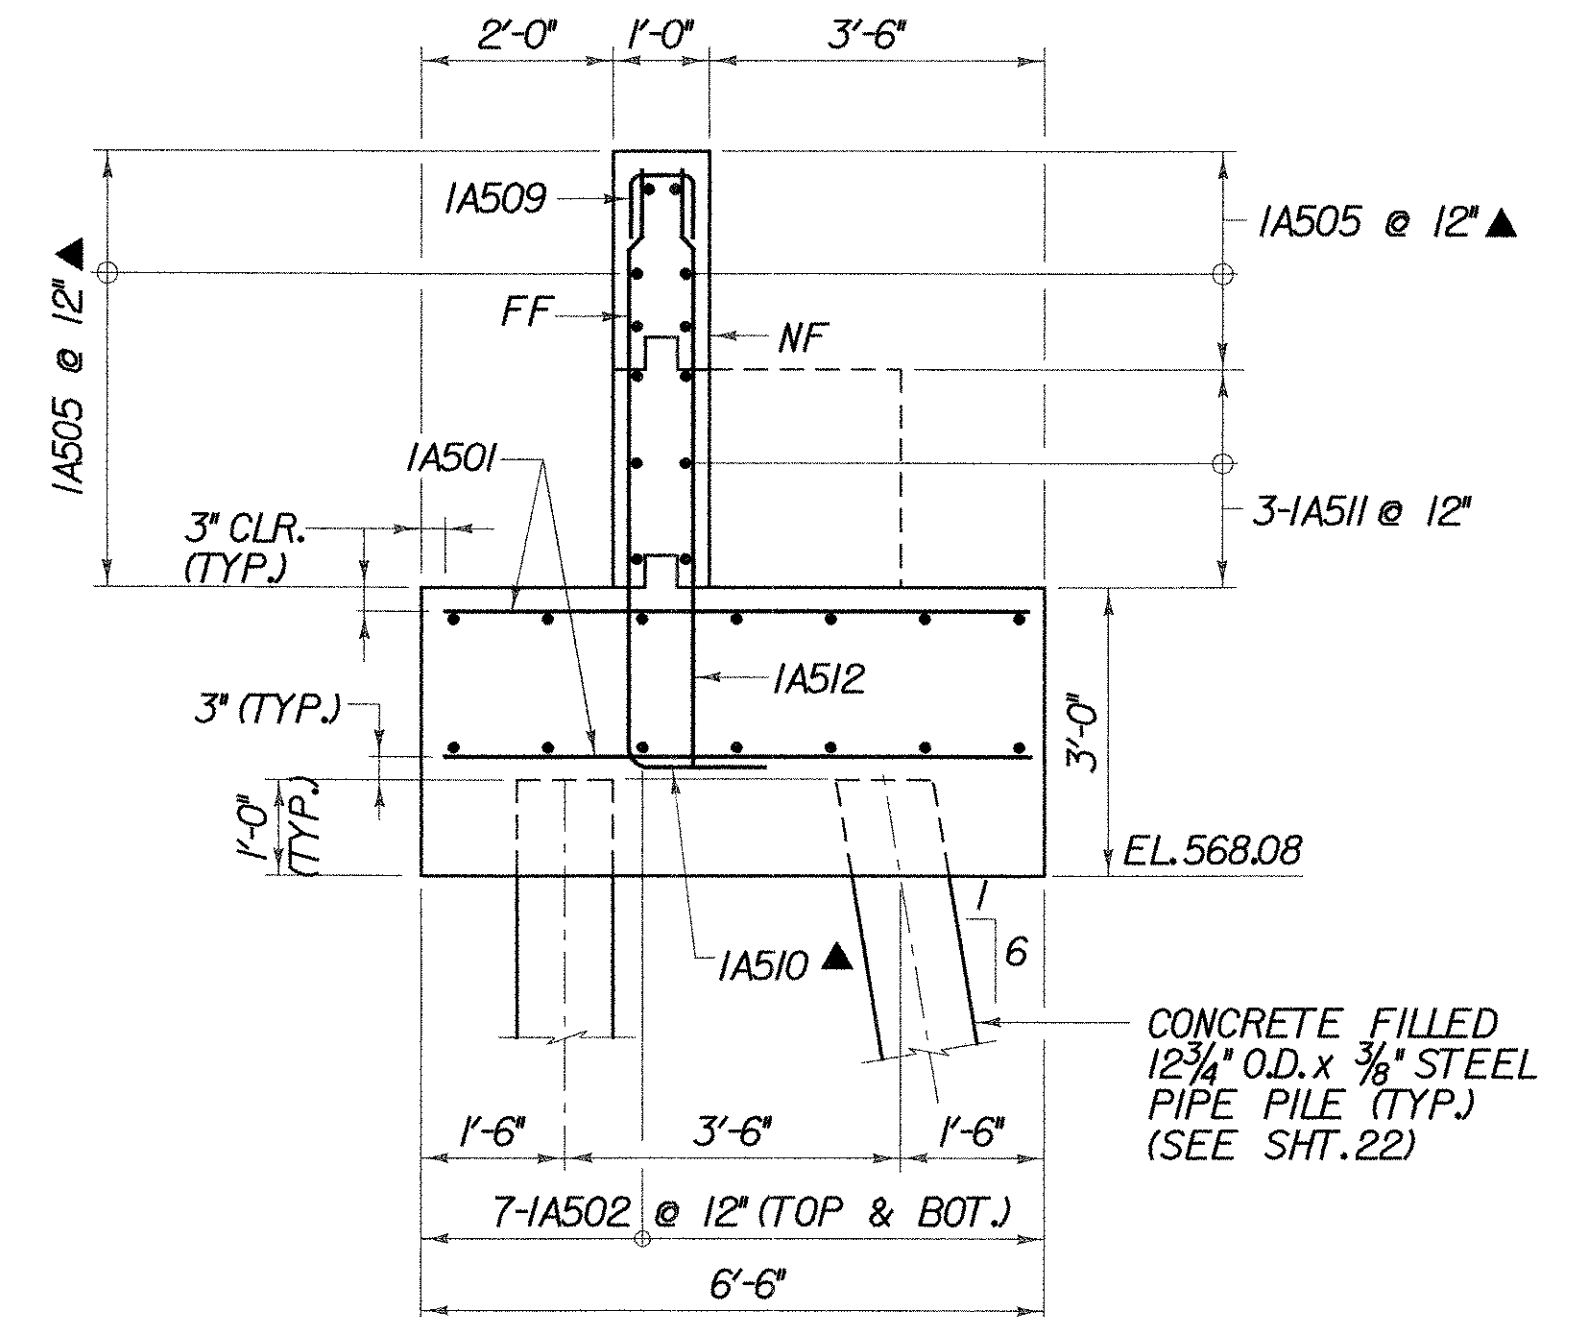

B TYPICAL WINGWALL SECTION
SCALE 1/2" = 1'-0"
1 0 1 2

NOTES:
1. THE IA506 REINFORCEMENT BARS SHALL BE PLACED TO AVOID ANCHOR ROD PLACEMENT.

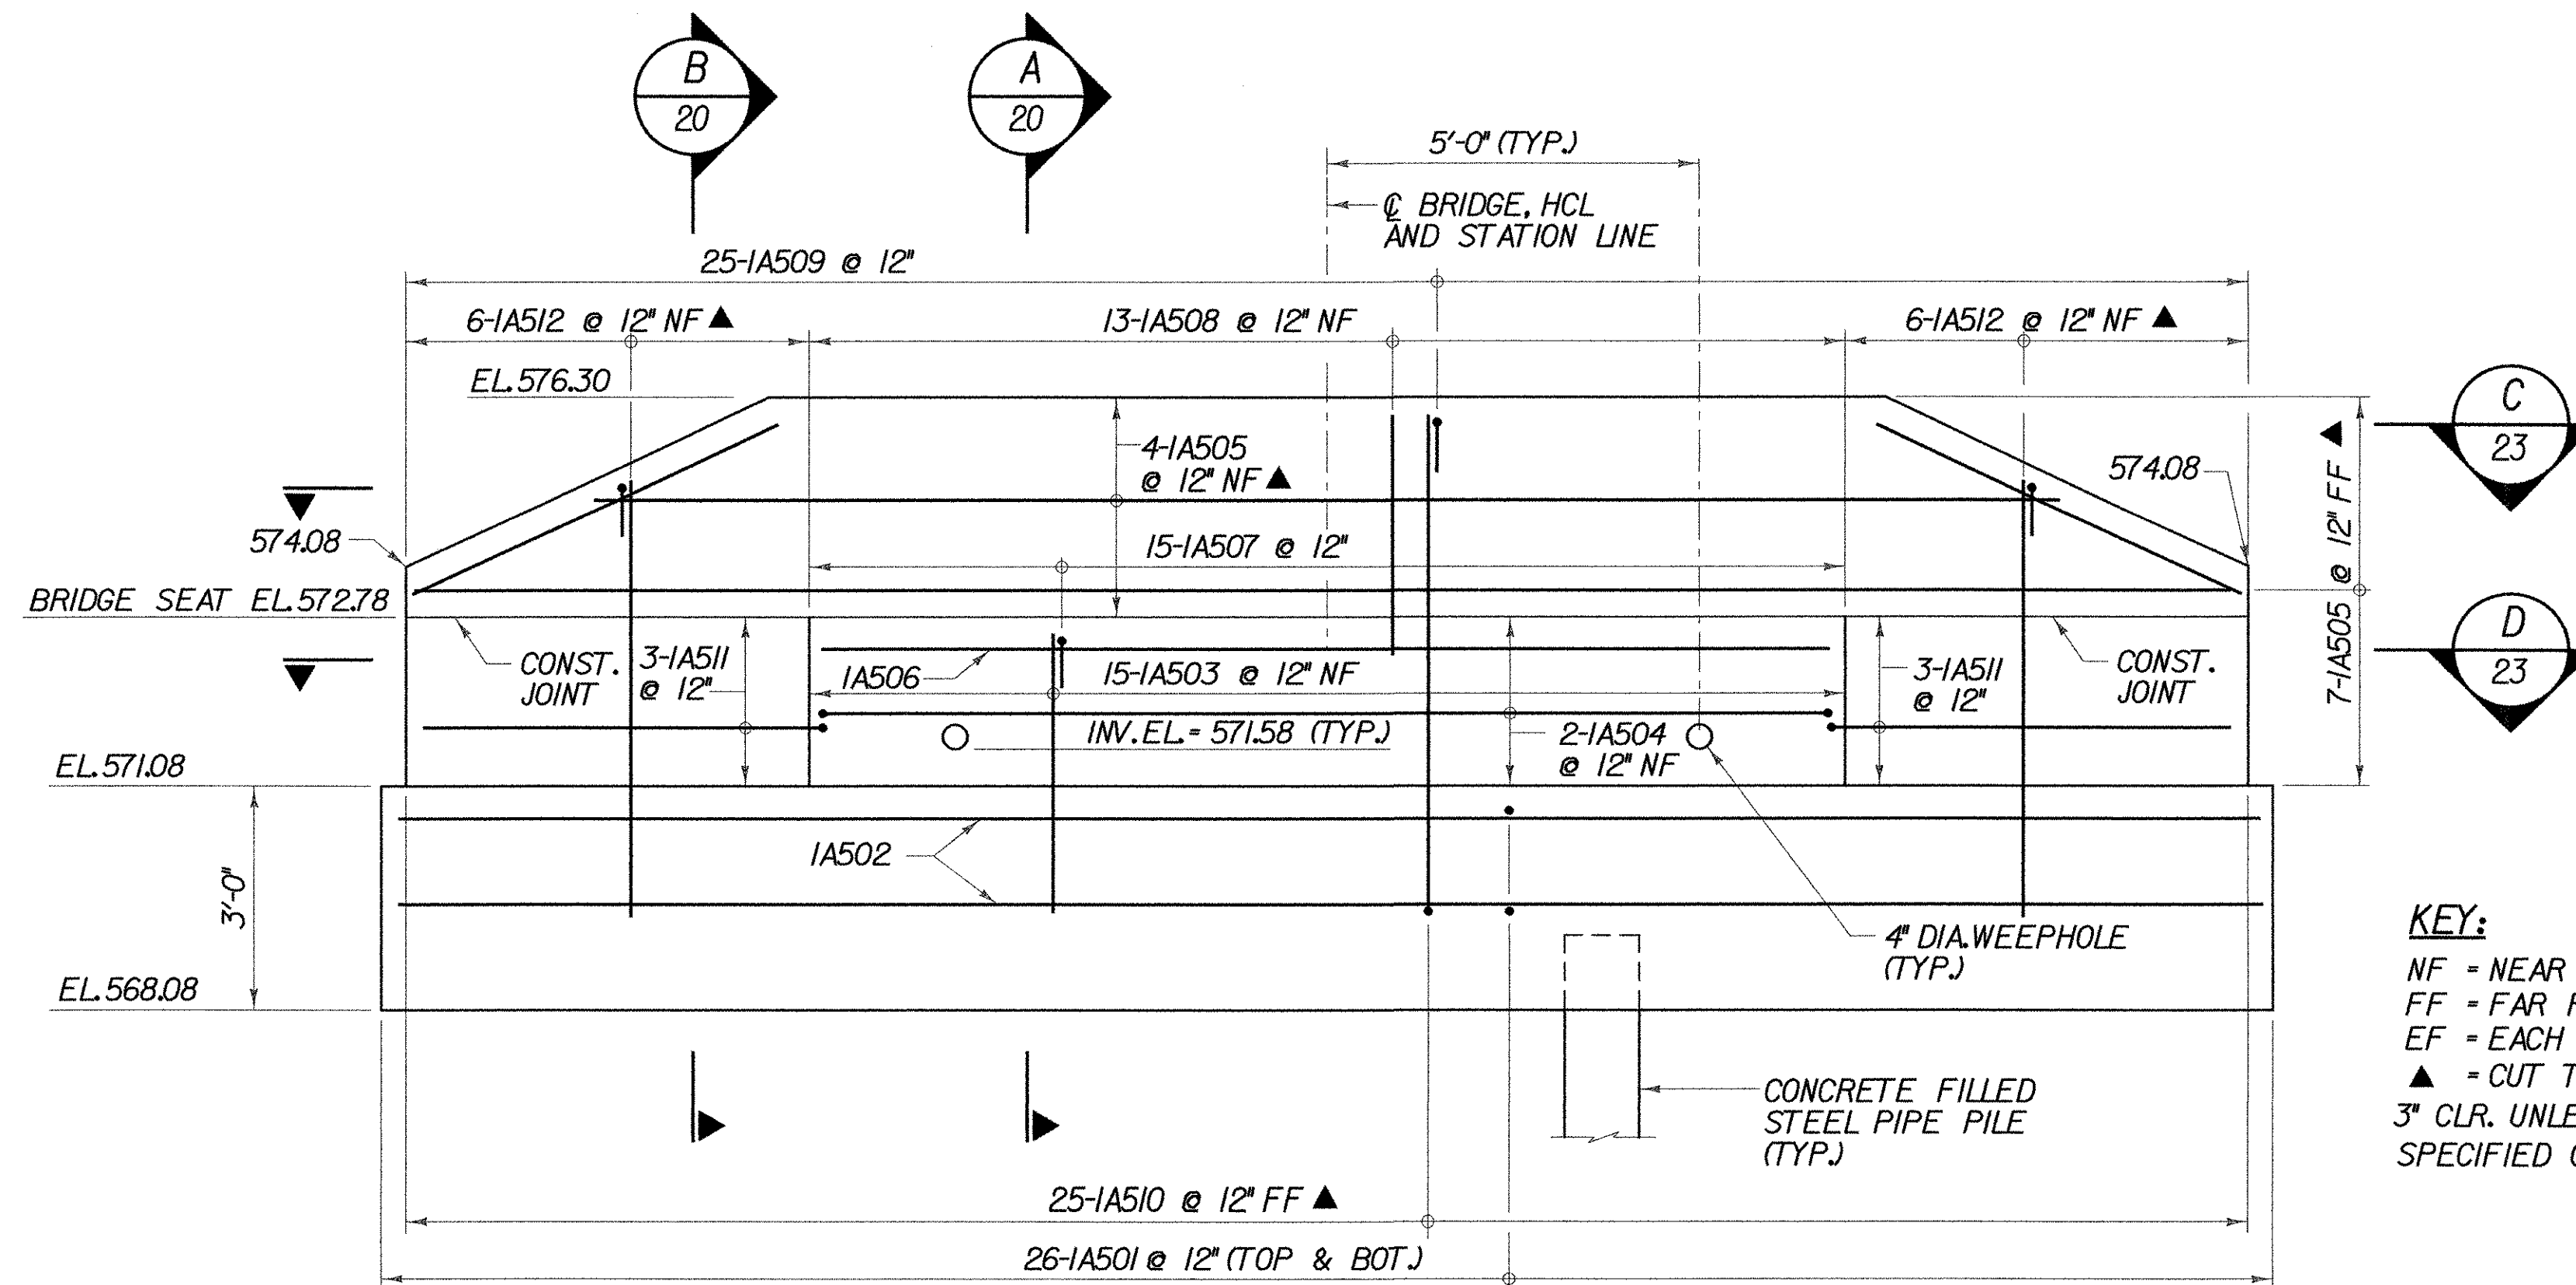

ELEVATION
SCALE 1/2" = 1'-0"
1 0 1 2

KEY:
NF = NEAR FACE
FF = FAR FACE
EF = EACH FACE
▲ = CUT TO FIT IN FIELD
3" CLR. UNLESS OTHERWISE SPECIFIED ON THE PLANS.

ABUTMENT I PLAN AND ELEVATION

PROJECT NAME: WALLINGFORD
PROJECT NUMBER: STP ST WALK(I4)

FILE NAME: \$FILES\$
PROJECT MANAGER: SUSAN SCRIBNER
DESIGNED BY: L. HARDEN
BRIDGE DESIGN SUPERVISOR: P. HALSTEAD

PLOT DATE: 1/9/2009
DRAWN BY: W. WEATHERBY
CHECKED BY: P. HALSTEAD
SHEET 20 OF 26

