



BEARING PEDESTAL:

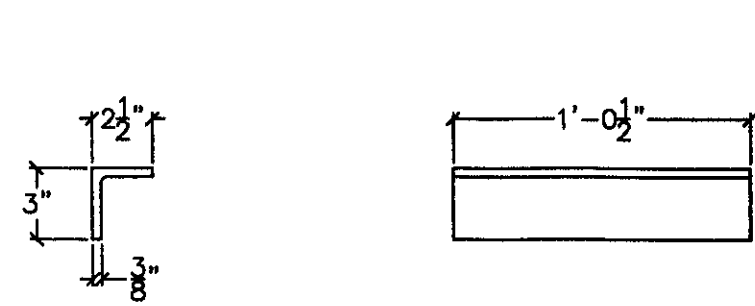


1BP05-ANGLE

3" = 1'-0"

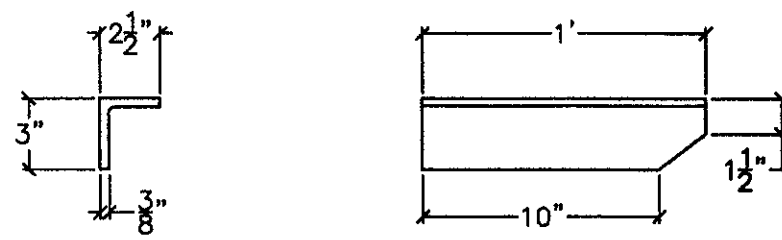

1BP06R-ANGLE

3" = 1'-0"

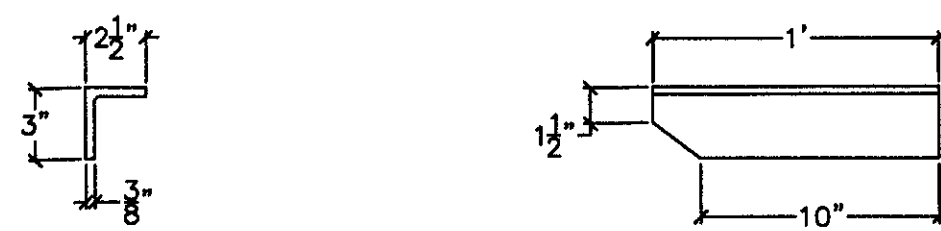

1BP06R-ANGLE

3" = 1'-0"

DIMENSIONS TBD

1BP07-PLATE

3" = 1'-0"

RECEIVED
OK'D BY CMA OK'D BY _____
MAY 11 2011
BY WJ DATE 5/11/11
APPROVED ✓

DRAWING NO.		T-1		SHEET NO.		2 OF 17	
TITLE		Wallingford Bridge Rehab		DRAWINGS TRUSS TYPE 1		DRAWINGS	
LOCATION		Wallingford, VT		JOB CONTACT		ERICK FOSTER STATE OF VT	
DRAWING TITLE		DRAWINGS TRUSS TYPE 1		DRAWN BY JED		CHECKED BY JED/AD	
				DATE		4 30 09	