



BEARING PEDESTAL:

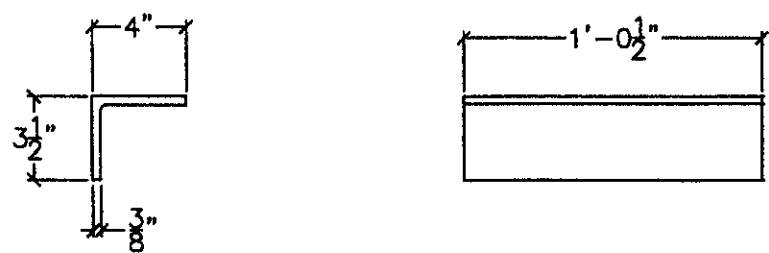

1BA01-ANGLE
3" = 1'-0"

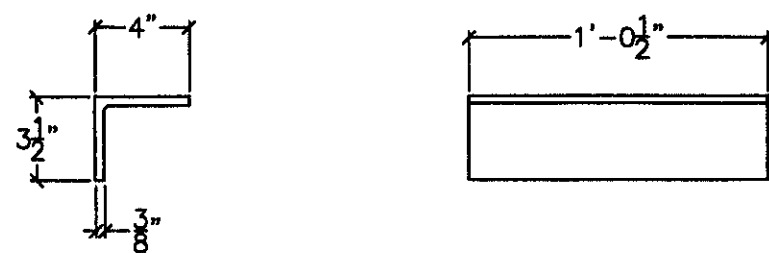

1BA02-ANGLE
3" = 1'-0"

RECEIVED
CK'D BY CWA OK'D BY _____
MAY 11 2011
APPROVED /
BY WJ DATE 5/11/11

Renard Bros Construction Professional Engineer (802) 257-7383	
TITLE Wallingford Bridge Rehab LOCATION Wallingford, VT	DRAWING TITLE Drawings Truss Type 1: Drawings
DRAWN BY JED	JOB CONTACT Eric Foster State of VT
CHECKED BY JED/AD	DATE 4 30 09
DRAWING NO.	T-1
SHEET NO.	3 OF 17