




UPPER CHORD:

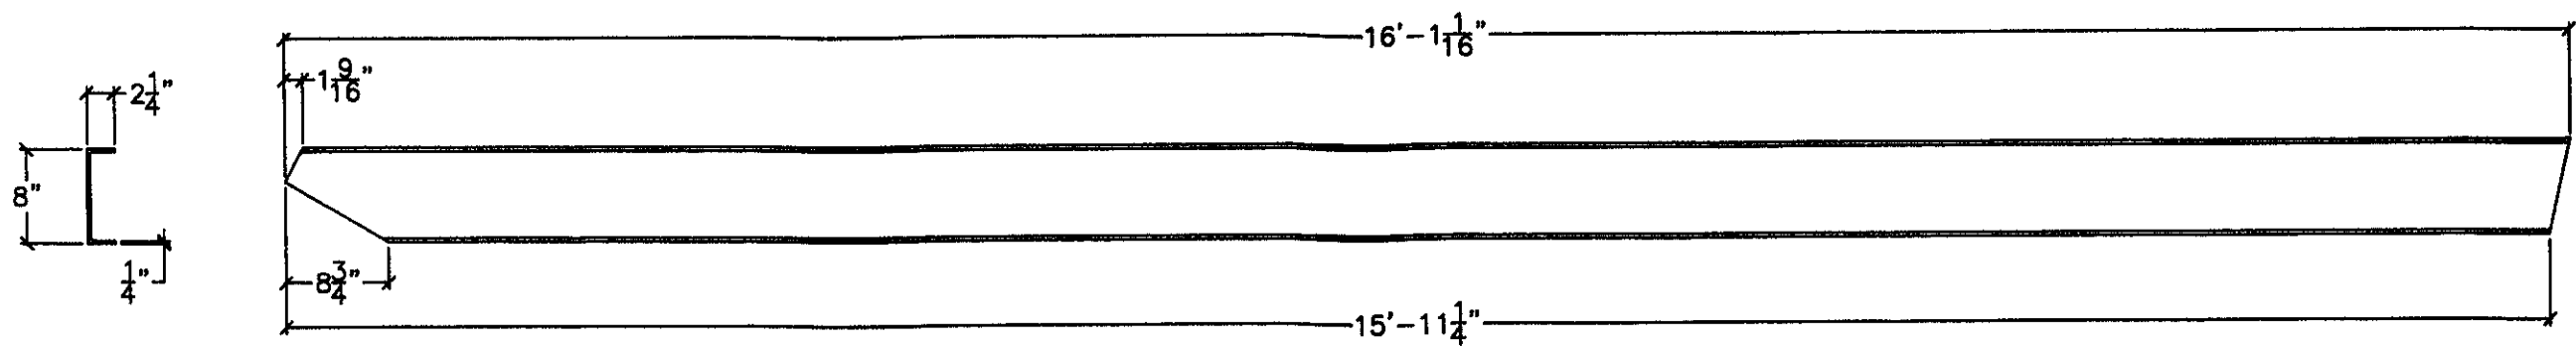

1LOU1-CHANNEL
1-1/2" = 1'-0"

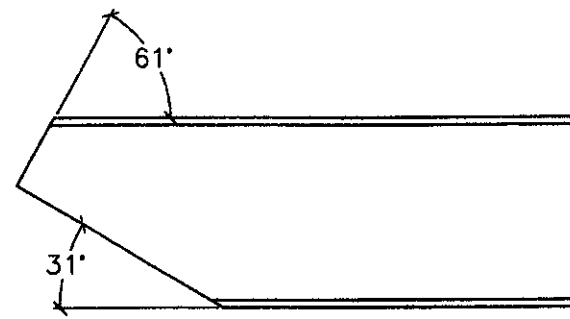

1LOU1-END DETAIL
3" = 1'-0"

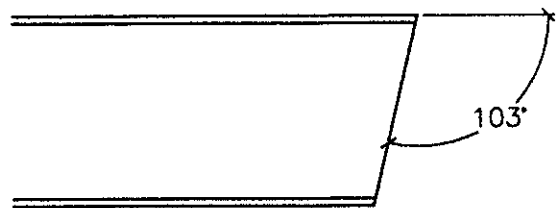

1LOU1-END DETAIL
3" = 1'-0"

RECEIVED
CHK'D BY: CUB OK'D BY: WJ
MAY 11 2011
APPROVED: WJ
DATE: 5/11/11

Pleasant Bros. Construction P.O. Box 100 (802) 257-7283	
FILE	Wallingford Bridge Rehab
LOCATION	Wallingford, VT
DRAWING TITLE	Drawings Truss Type 1. Drawings
DRAWN BY	JED
JOB CONTACT	Enck Foster State of VT
CHECKED BY	JED/AD
DATE	4/30/09
DRAWING NO.	T-1
SHEET NO.	5 of 17