




UPPER CHORD:

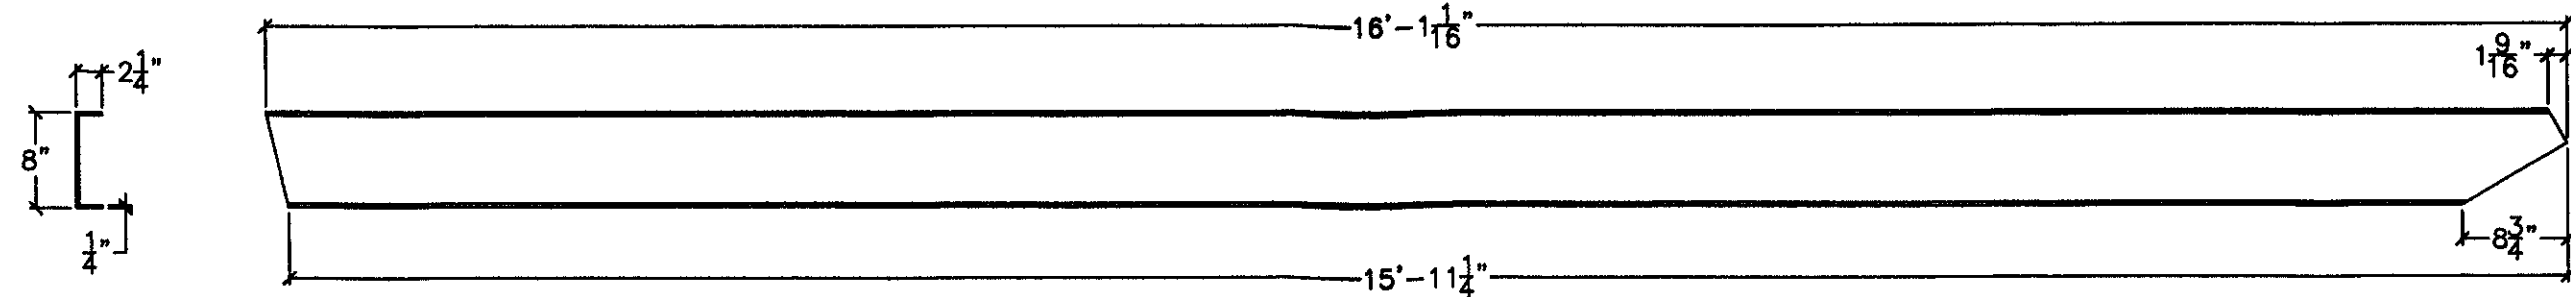

1L8U7-CHANNEL
1-1/2" = 1'-0"

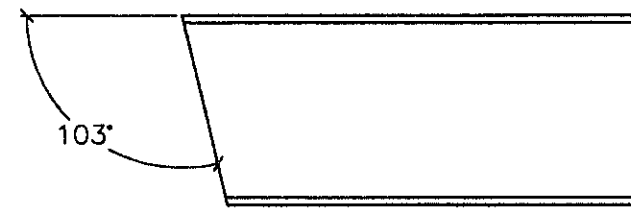

1L8U7-END DETAIL
3" = 1'-0"

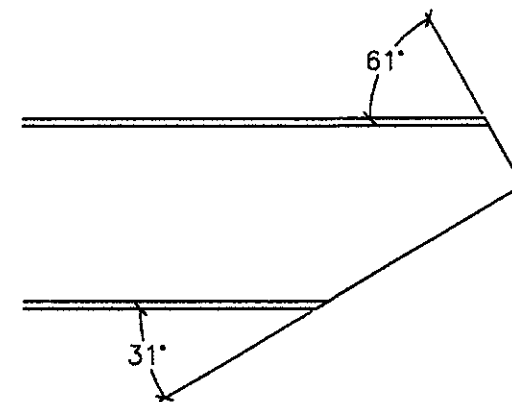

1L8U7-END DETAIL
3" = 1'-0"

RECEIVED
MAY 11 2011
APPROVED
BY *WJ* DATE 5/11/11

PROJECT: Wallingford Bridge Rehab	LOCATION: Wallingford, VT	DRAWING TITLE: Drawings Truss Type 1	DRAWN BY: JED	CHECKED BY: JED/AD	DATE: 4/30/09	JOB CONTACT: Enck Foster State of VT
DRIVING NO.	T-1	SHEET NO.	6 OF 17	Enck Foster Construction For Bridge Road Work, VT 05354 (802) 257-7383		