




UPRIGHT MEMBERS:

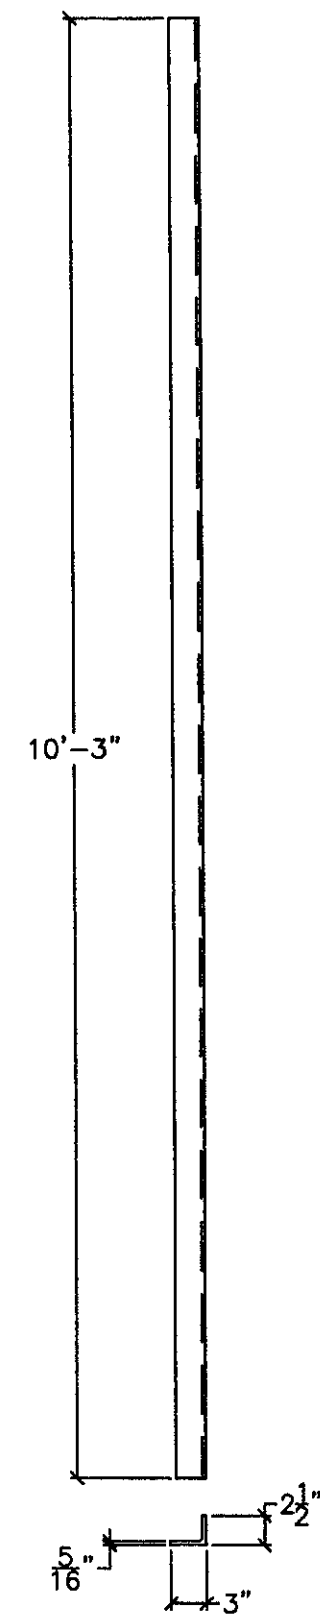

1U2L2L-ANGLE
1-1/2" = 1'-0"

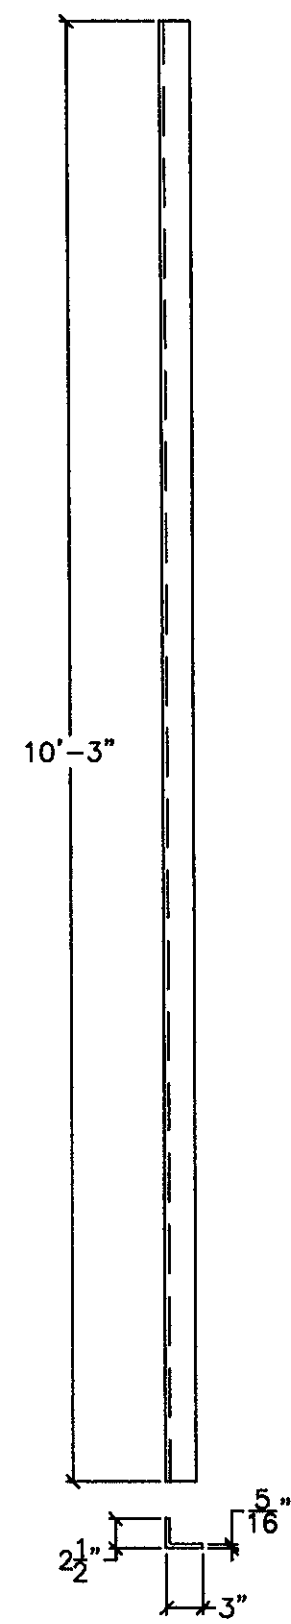

1U2L2R-ANGLE
1-1/2" = 1'-0"

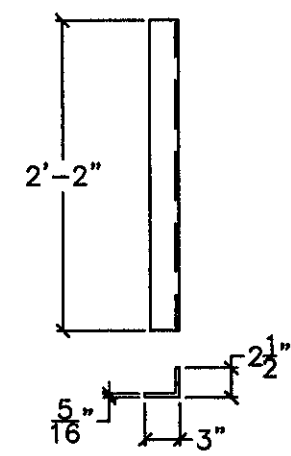

1U3L3L-ANGLE
1-1/2" = 1'-0"

RECEIVED
 OK'D BY CWA OK'D BY _____
 MAY 1 1 2009
 BY WY SJ DATE 5/1/09

FILE LOCATION DRAWING TITLE DRAWN BY CHECKED BY	Wallingford Bridge Rehab Wallingford, VT Drawings Truss Type 1 Drawings JED ED/AD	Renewal Bros. Construction 1000 Main Street (802) 257-7385
DRAWING NO. SHEET NO.	T-1 7 OF 17	