
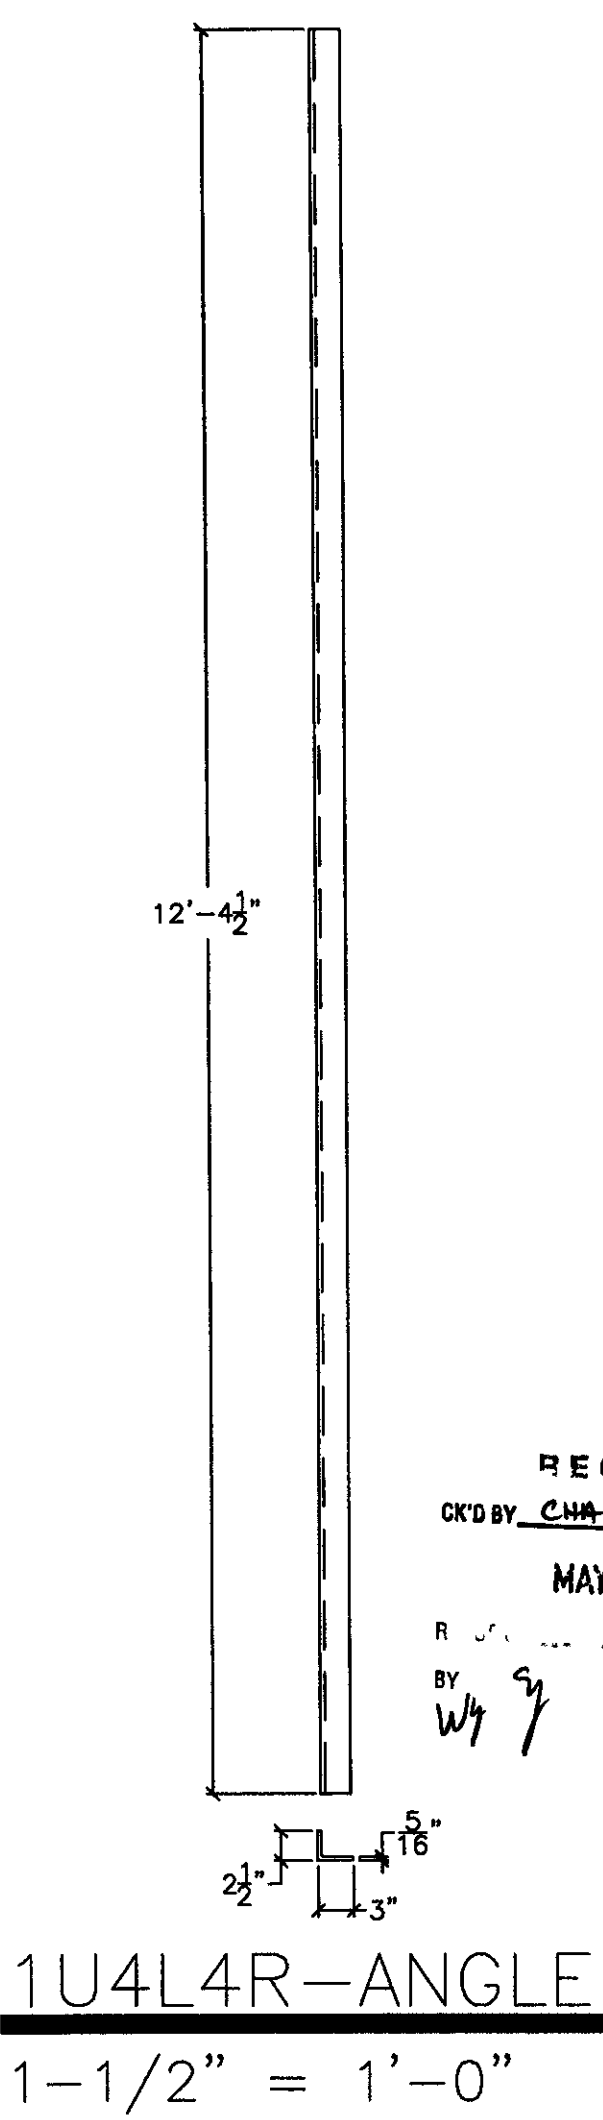
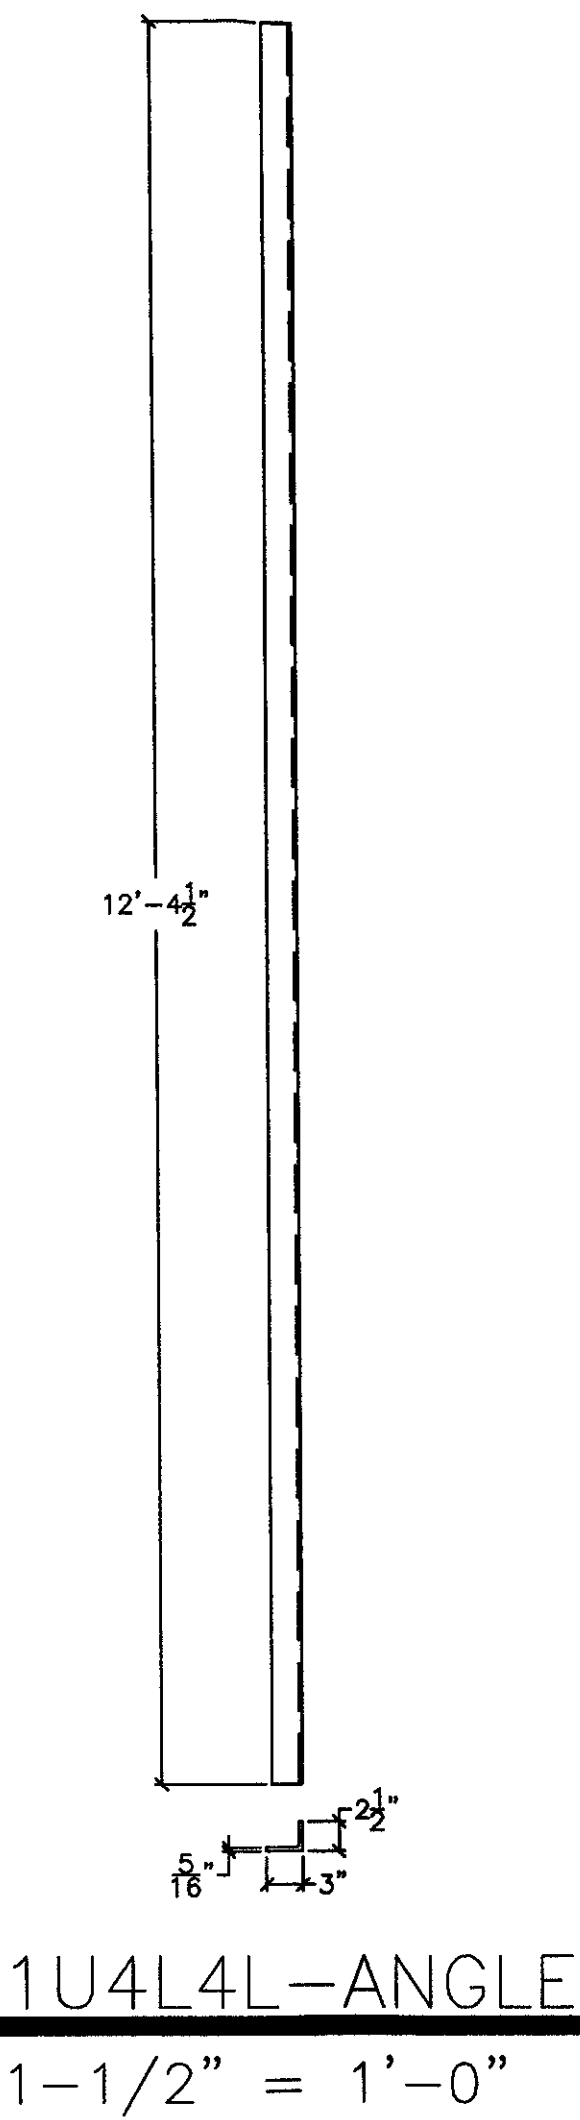


UPRIGHT MEMBERS:

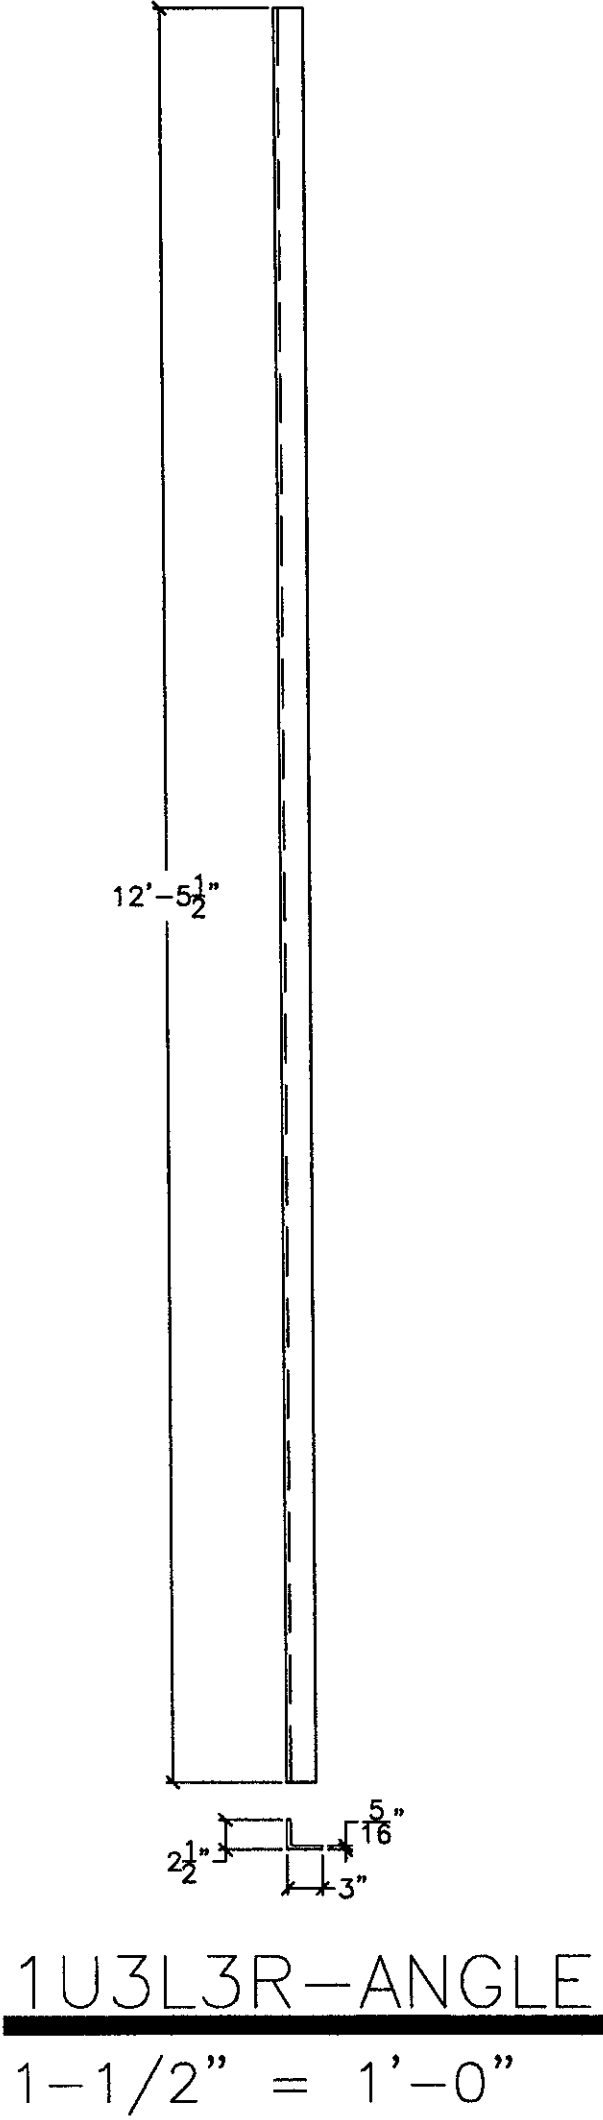

RECEIVED
CHK'D BY: CHH OK'D BY: _____
MAY 1 1 2009
BY: WJ DATE: 5/1/09

Renaud Bros. Construction Wallingford, VT (802) 257-7983	
FILE	Wallingford Bridge Rehab
LOCATION	Wallingford, VT
DRAWING TITLE	Drawings Truss Type 1 Drawings
DRAWN BY	JED
CHECKED BY	JED/AD
DATE	4 30 09
DRAWING NO.	T-1
SHEET NO.	8 of 17