



UPRIGHT MEMBERS:

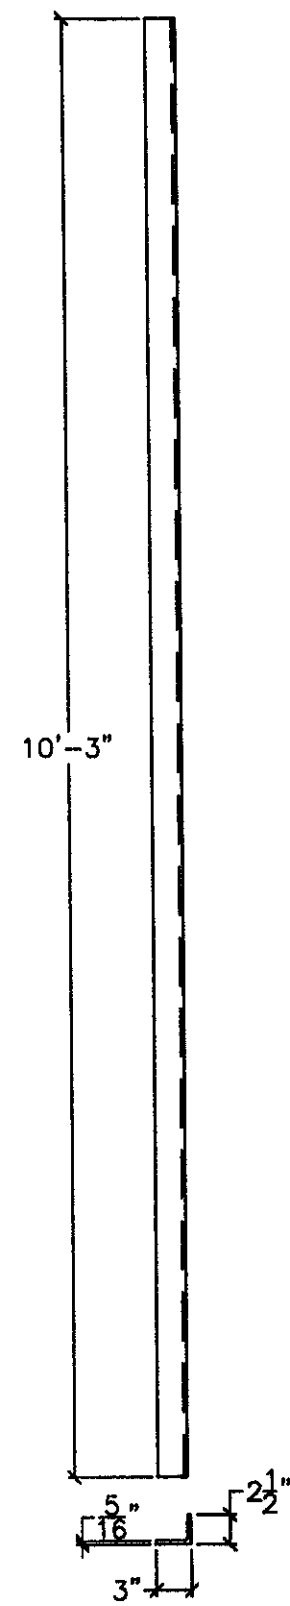

1U6L6L-ANGLE
1-1/2" = 1'-0"

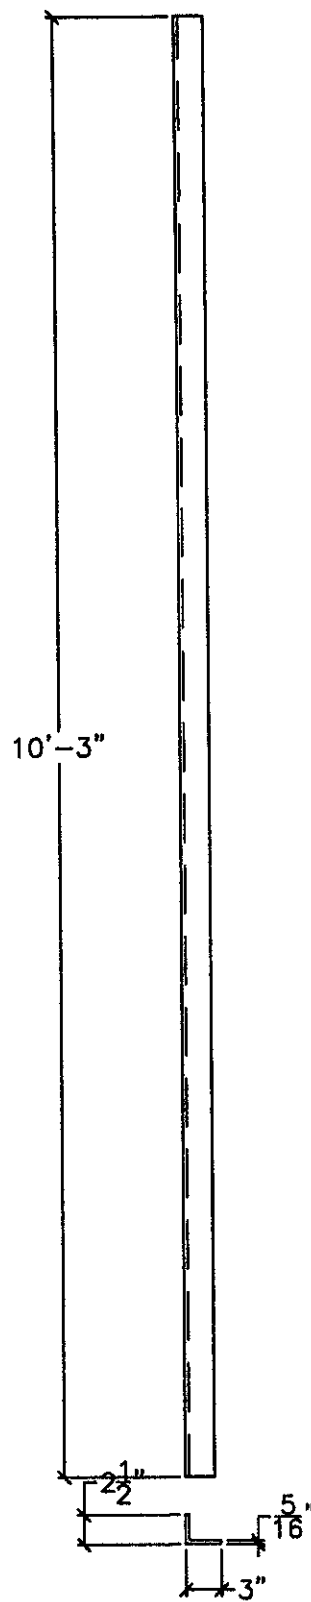

1U6L6R-ANGLE
1-1/2" = 1'-0"

RECEIVED
OK'D BY CJA OK'D BY _____
MAY 11 2009
BY WJ DATE 5/19/09

Renaud Bros. Construction Renaud Bros. Construction (802) 257-7383	
TITLE: Wallingford Bridge Rehab	
LOCATION: Wallingford, VT	DRAWING TITLE: Drawings Truss Type 1
DRAWN BY: JED	JOB CONTACT: Erick Foster State of VT
CHECKED BY: JED/AD	DATE: 4.30.09
DRAWING NO.: T-1	
SHEET NO.: 9 of 17	