



UPRIGHT MEMBERS:

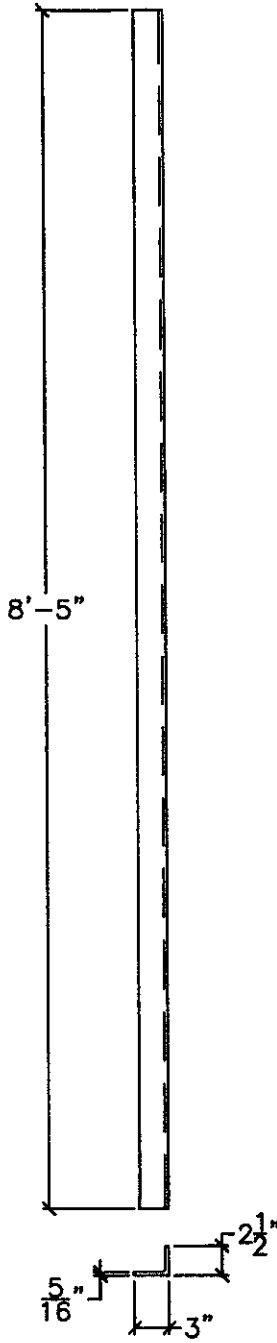

1U7L7L-ANGLE
1-1/2" = 1'-0"

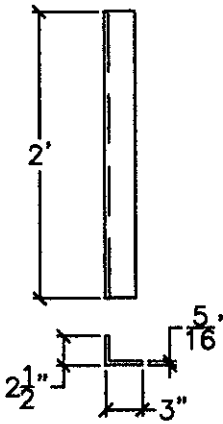

1U7L7R-ANGLE
1-1/2" = 1'-0"

RECEIVED
CHK'D BY CWA OK'D BY _____
MAY 11 2009
BY WJ/SJ DATE 5/11/09

Renaud Bros. Construction Renaud Bros. Construction (802) 257-7393	
TITLE Wallingford Bridge Rehab Wallingford, VT	DRAWING TITLE Drawings Truss Type 1 Drawings
LOCATION	JOB CONTACT Eric Foster State of VT
DRAWN BY JED	DATE 4 30 09
CHECKED BY JED/AD	
DRAWING NO. T-1	
SHEET NO. 10 of 17	