

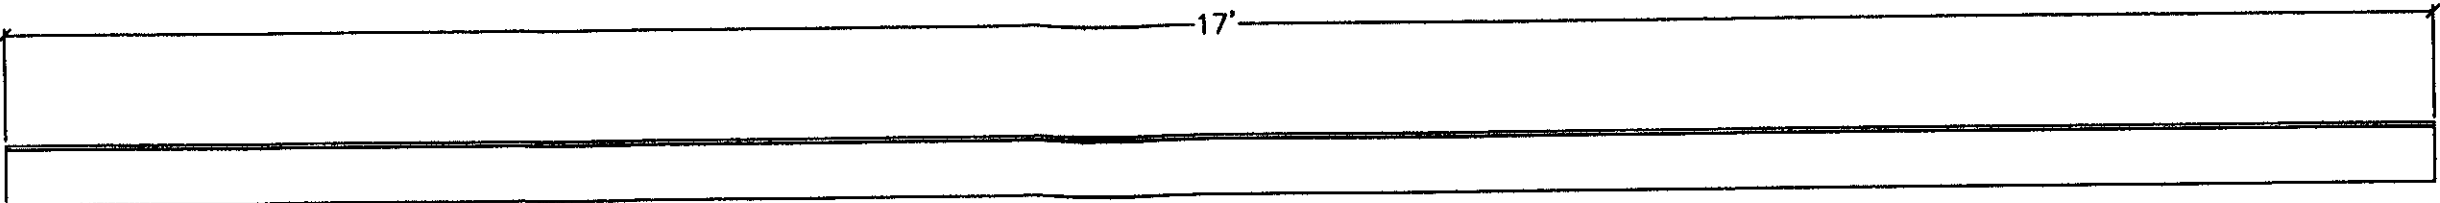
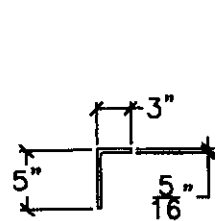




UPRIGHT MEMBERS:

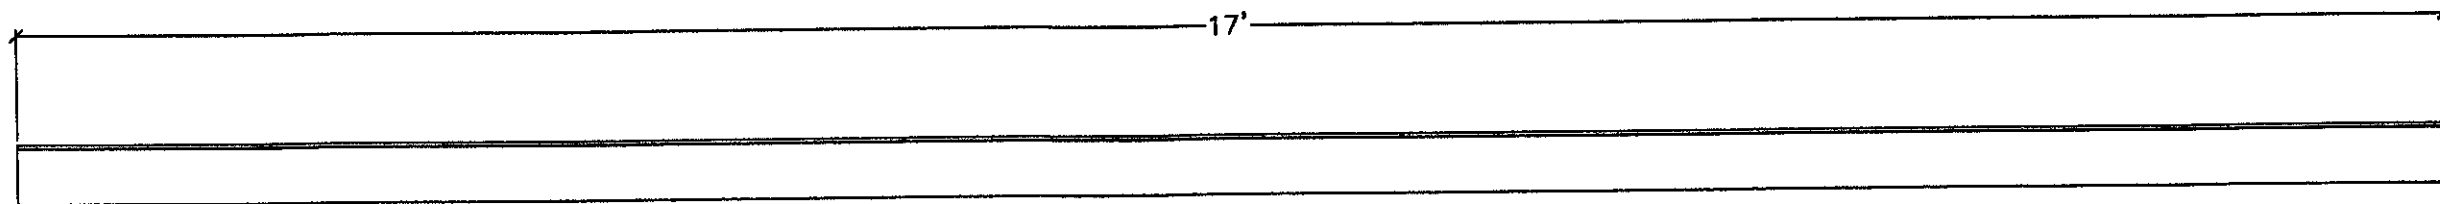

1DM01-ANGLE
1-1/2" = 1'-0"

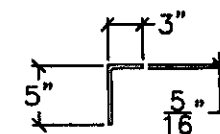

1DM02-ANGLE
1-1/2" = 1'-0"

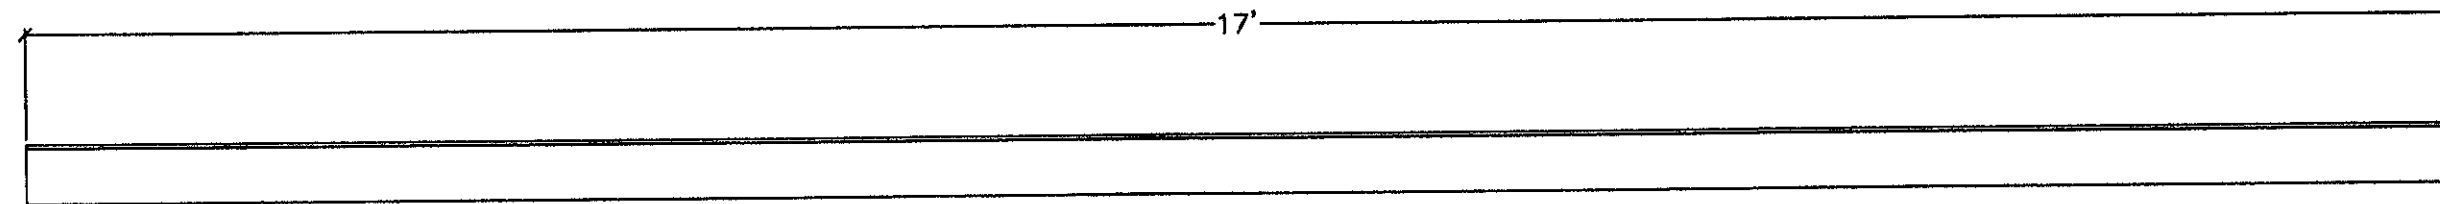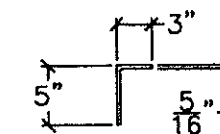

1DM03-ANGLE
1-1/2" = 1'-0"

RECEIVED
CHK'D BY CNA OK'D BY _____
MAY 11 2009
BY WY Sp APPROVED [initials]
DATE 5/11/09

Renard Bros. Construction Fort Bridgman Road, Vermont, VT 05354 (802) 257-7363	
TITLE	Wallingford Bridge Rehab
LOCATION	Wallingford, VT
DRAWING TITLE	Drawings Truss Type 1 Drawings
DRAWN BY	JED
JOB CONTACT	Enck Foster State of VT
CHECKED BY	JED/AD
DATE	4 30 09
DRAWING NO.	T-1
SHEET NO.	11 of 17