

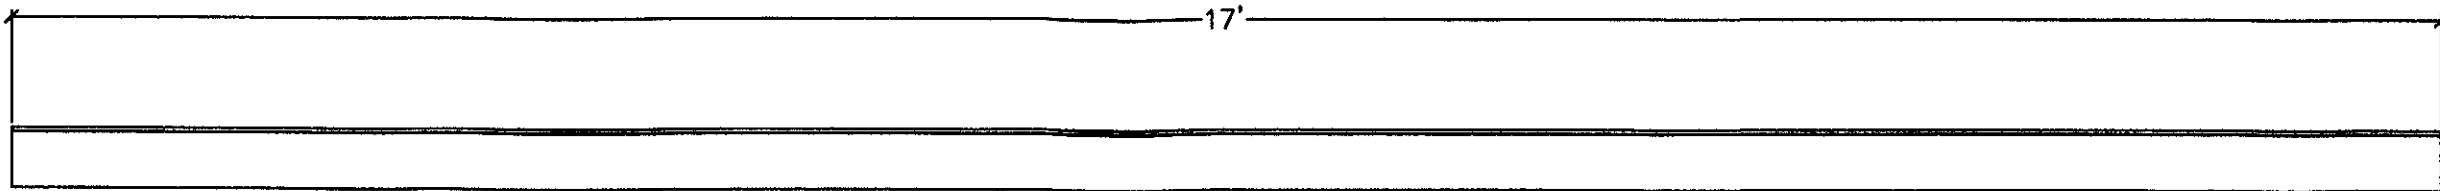


UPRIGHT MEMBERS:

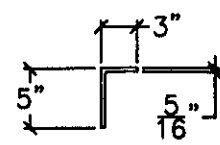

1DM04-ANGLE

1-1/2" = 1'-0"

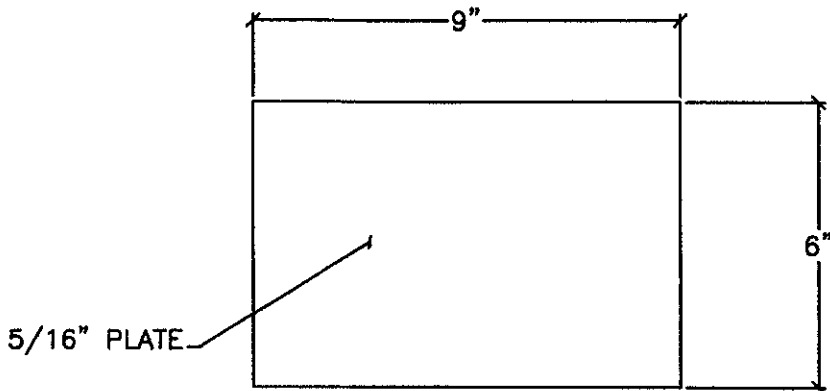

- plates similar for U362, U364, U564 and U566

1DM05-PLATE

3" = 1'-0"

RECEIVED
CHK'D BY CHP OK'D BY _____

MAY 11 2009

BY WJ DATE 5/4/09

Renaud Bros. Construction Renaud Bros. Construction (802) 257-7285	
Wallingford Bridge Rehab Wallingford, VT	
DRAWING TITLE Drawings Truss Type 1. Drawings	
DRAWN BY <u>JE</u>	JOB CONTACT <u>Erick Foster State of VT</u>
CHECKED BY <u>JE</u>	DATE <u>4.30.09</u>
DRAWING NO. T-1	
SHEET NO. 12 OF 17	