



BOTTOM CHORD:

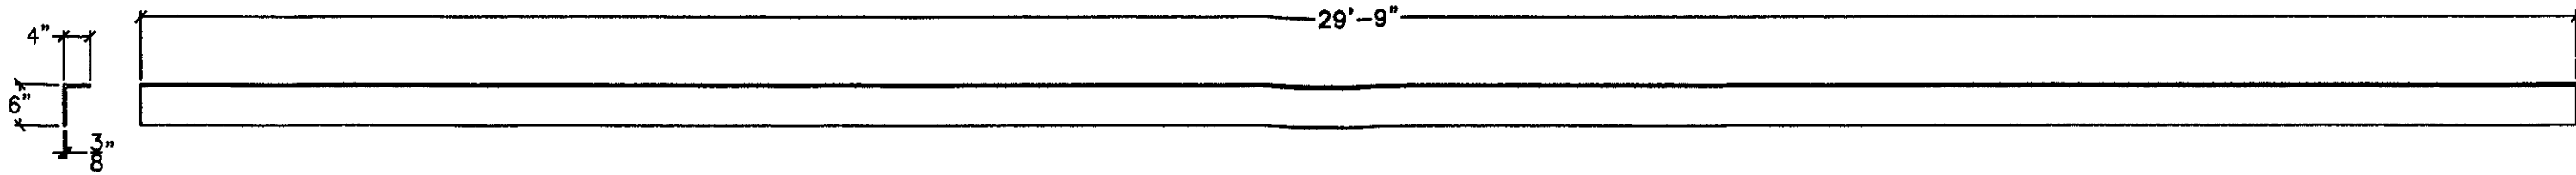


1L2L4A-ANGLE

1" = 1'-0"

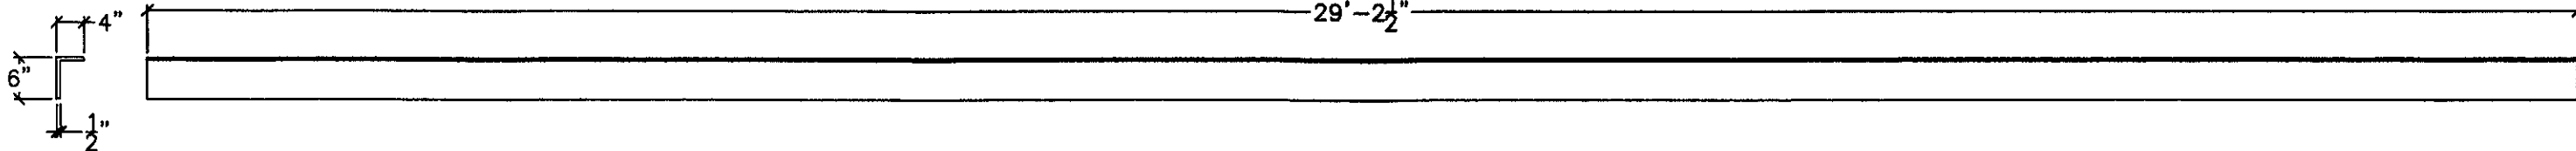

1L2L4A-ANGLE

1" = 1'-0"

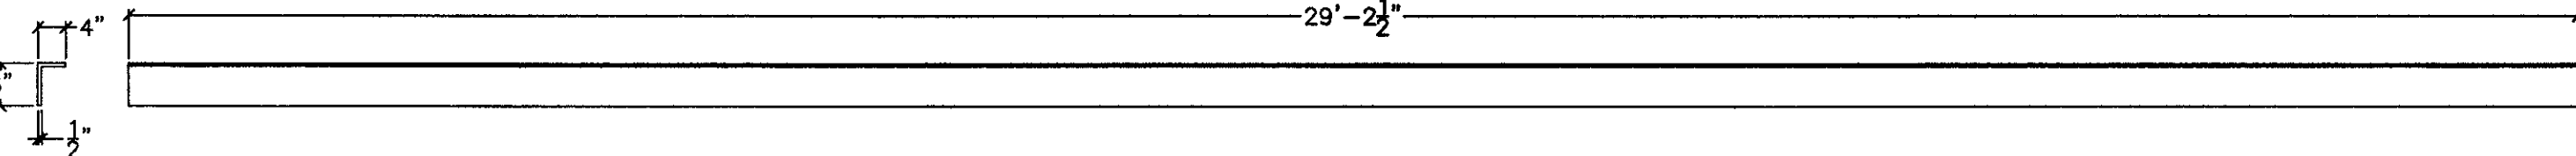

1L2L4B-ANGLE

1" = 1'-0"

RECEIVED
CHK'D BY CWA OK'D BY _____

MAY 11 2009

BY WJ DATE 5/29/09

Renaud Bros. Construction Renaud Bros. Construction (802) 257-7353	
TITLE: Wallingford Bridge Rehab LOCATION: Wallingford, VT	
DRAWING TITLE: Drawings Truss Type 1 Drawings	DRAWN BY: JED
CHECKED BY: JED/AD	DATE: 4/30/09
JOB CONTACT: Erick Foster State of VT	
DRAWING NO.: T-1	
SHEET NO.: 13 OF 17	