



BOTTOM CHORD:

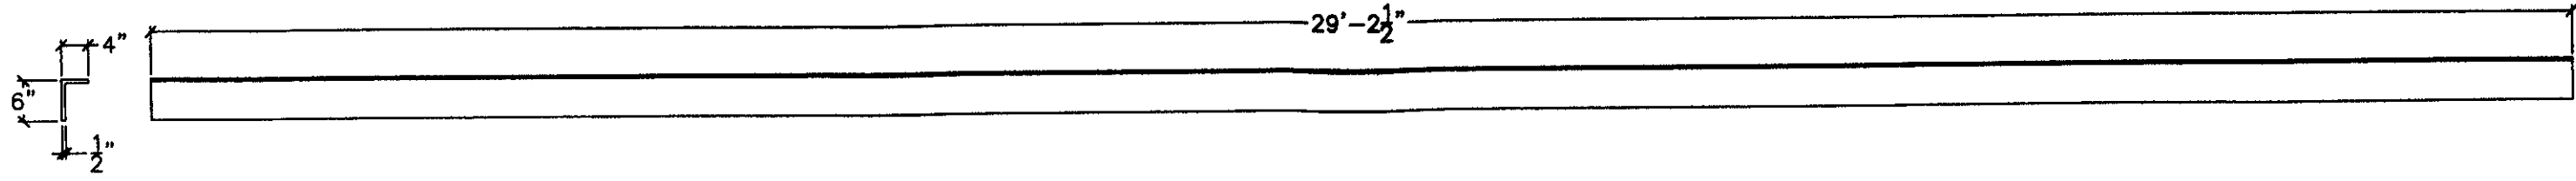


1L4L6A-ANGLE

1" = 1'-0"

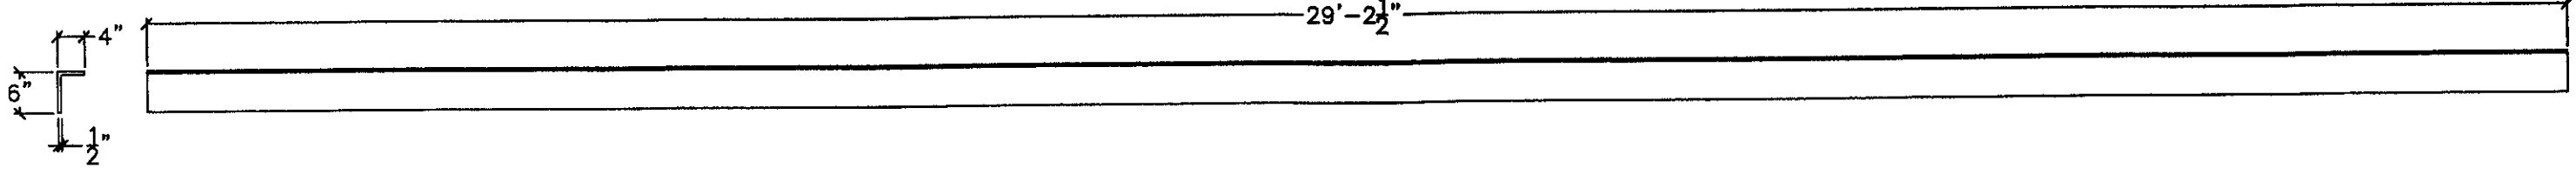

1L4L6B-ANGLE

1" = 1'-0"

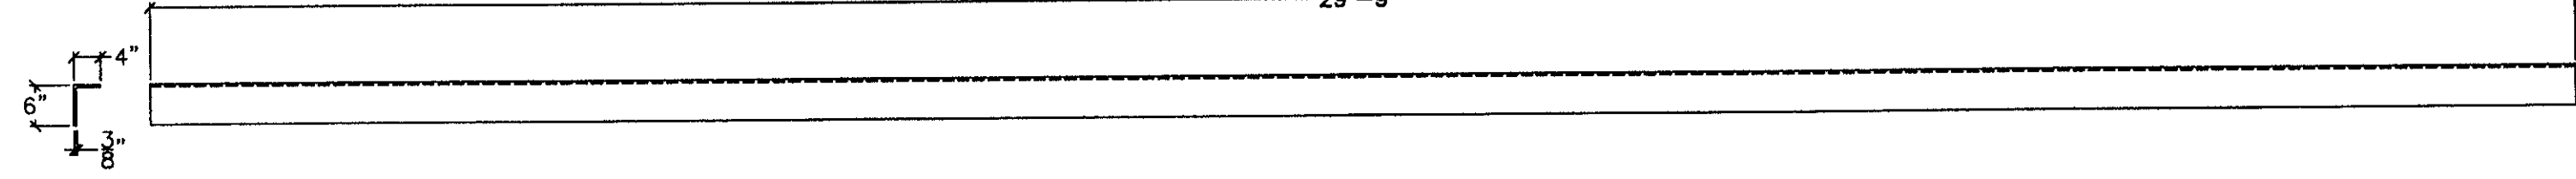

1L6L8A-ANGLE

1" = 1'-0"

RECEIVED
OK'D BY: CWA OK'D BY: _____
MAY 11 2009
BY: WY DATE: 5/11/09

Revised Eng. Construction For Bridge Rep. Mem. VT 0304 (802) 257-7383	
TITLE: Wallingford Bridge Rehab	
LOCATION: Wallingford, VT	DRAWING TITLE: Drawings Truss Type 1-
DRAWN BY: JED	JOB CONTACT: Erik Foster State of VT
CHECKED BY: JED/AD	DATE: 4 30 09
DRAWING NO.	T-1
SHEET NO.	14 of 17