



GUSSET PLATES:

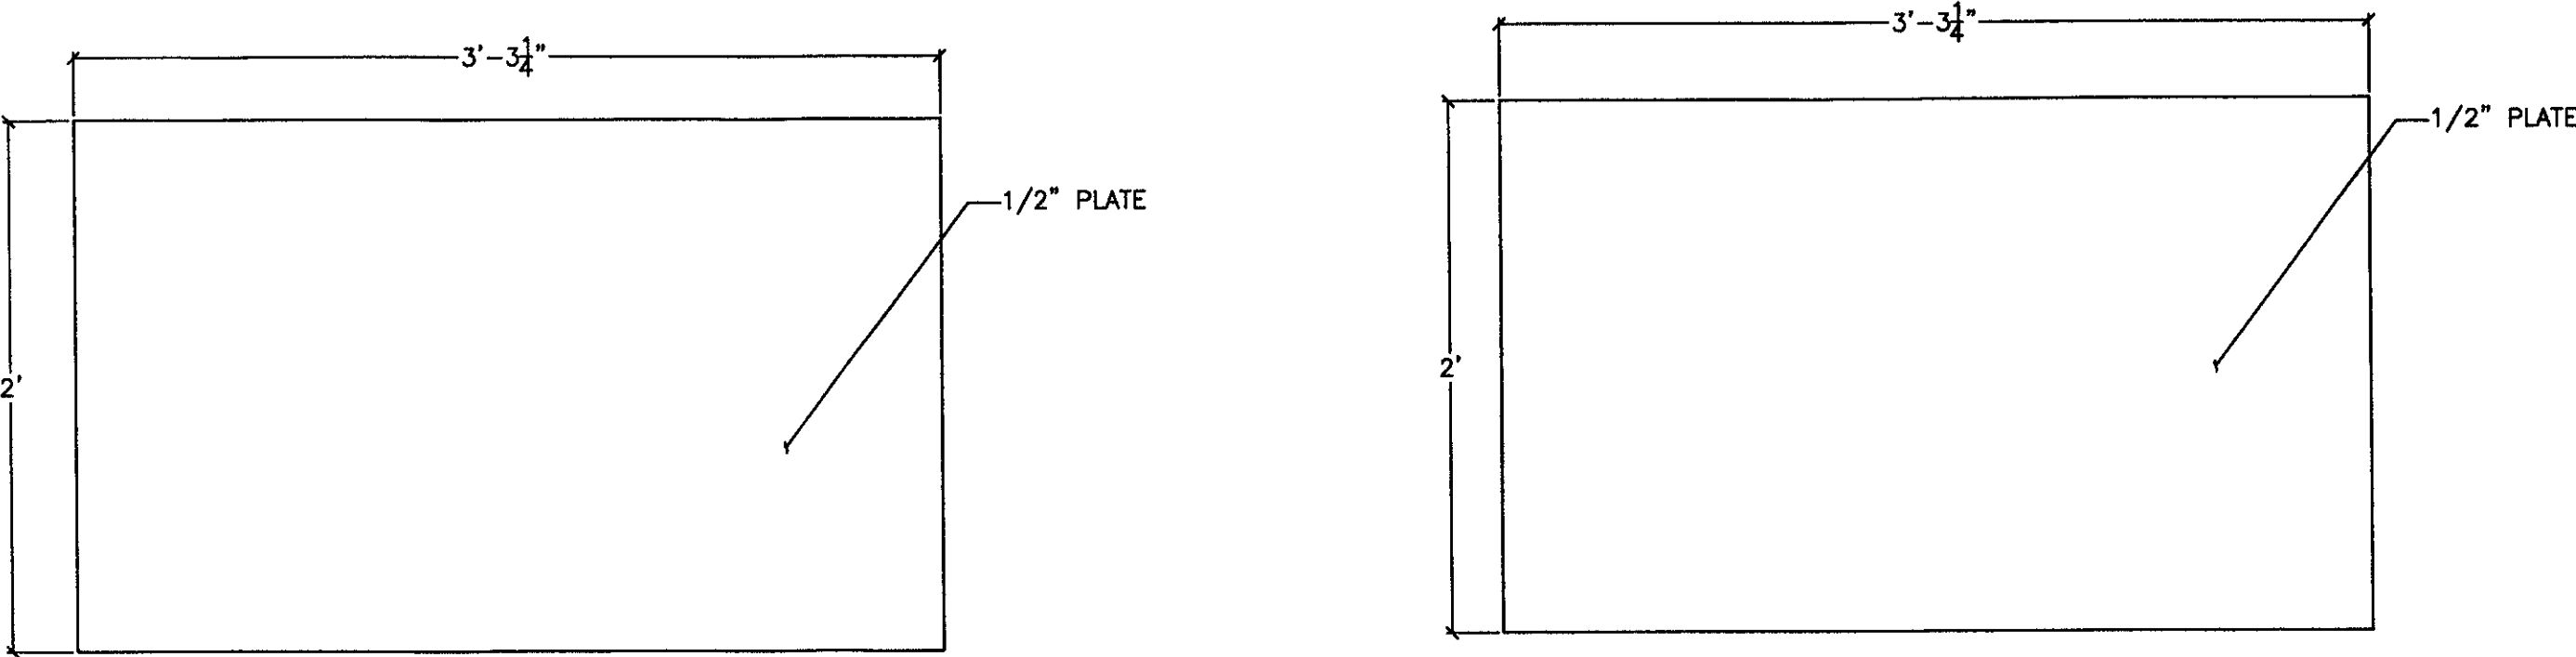

1GP01
3" = 1'-0"

1GP02
3" = 1'-0"

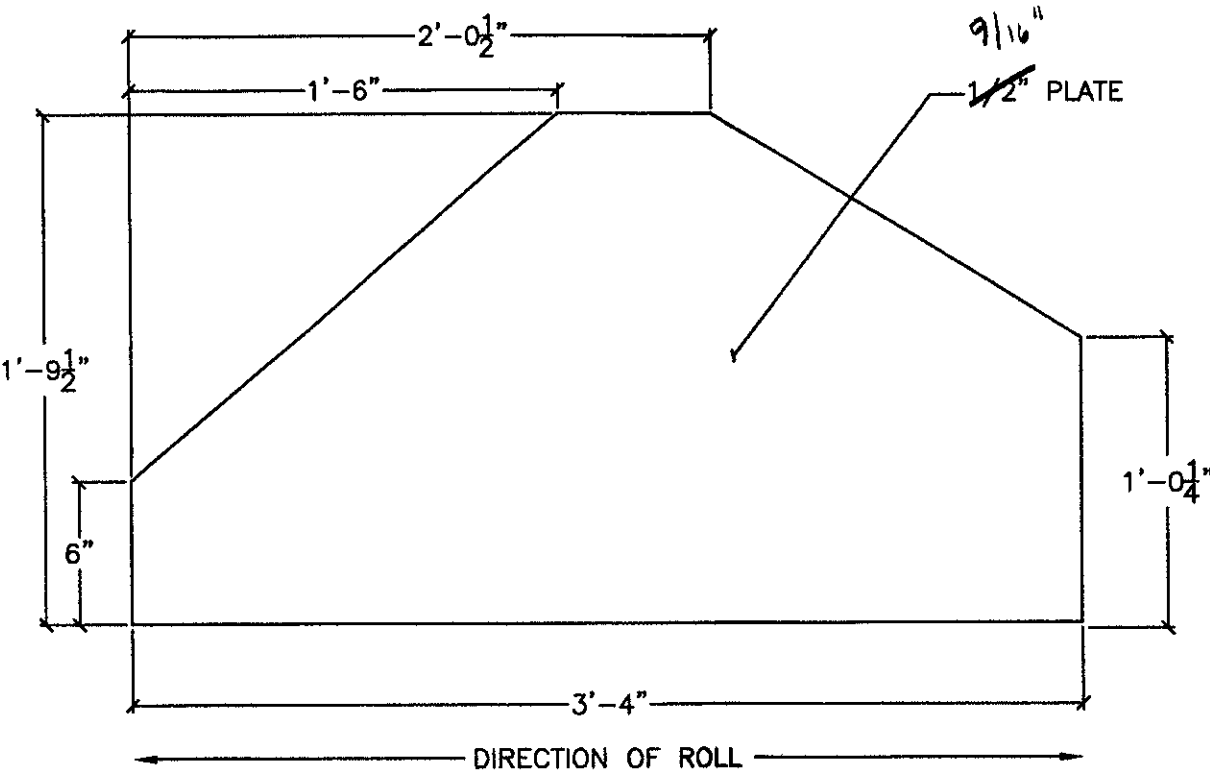

1GP03
3" = 1'-0"

RECEIVED
CHK'D BY CWA OK'D BY _____

MAY 11 2009
BY WY DATE 5/11/09

Grand Blue Construction 1000 Main Street, Suite 100 Wallingford, VT 05781 (802) 257-7383	
Wallingford Bridge Rehab Wallingford, VT	
DRAWING TITLE	Drawings Truss Type 1 Drawings
DRAWN BY	JED
CHECKED BY	JED/AD
JOB CONTACT	Erick Foster State of VT
DATE	4 30 09
DRAWING NO.	T-1
SHEET NO.	16 OF 17