



GUSSET PLATES:

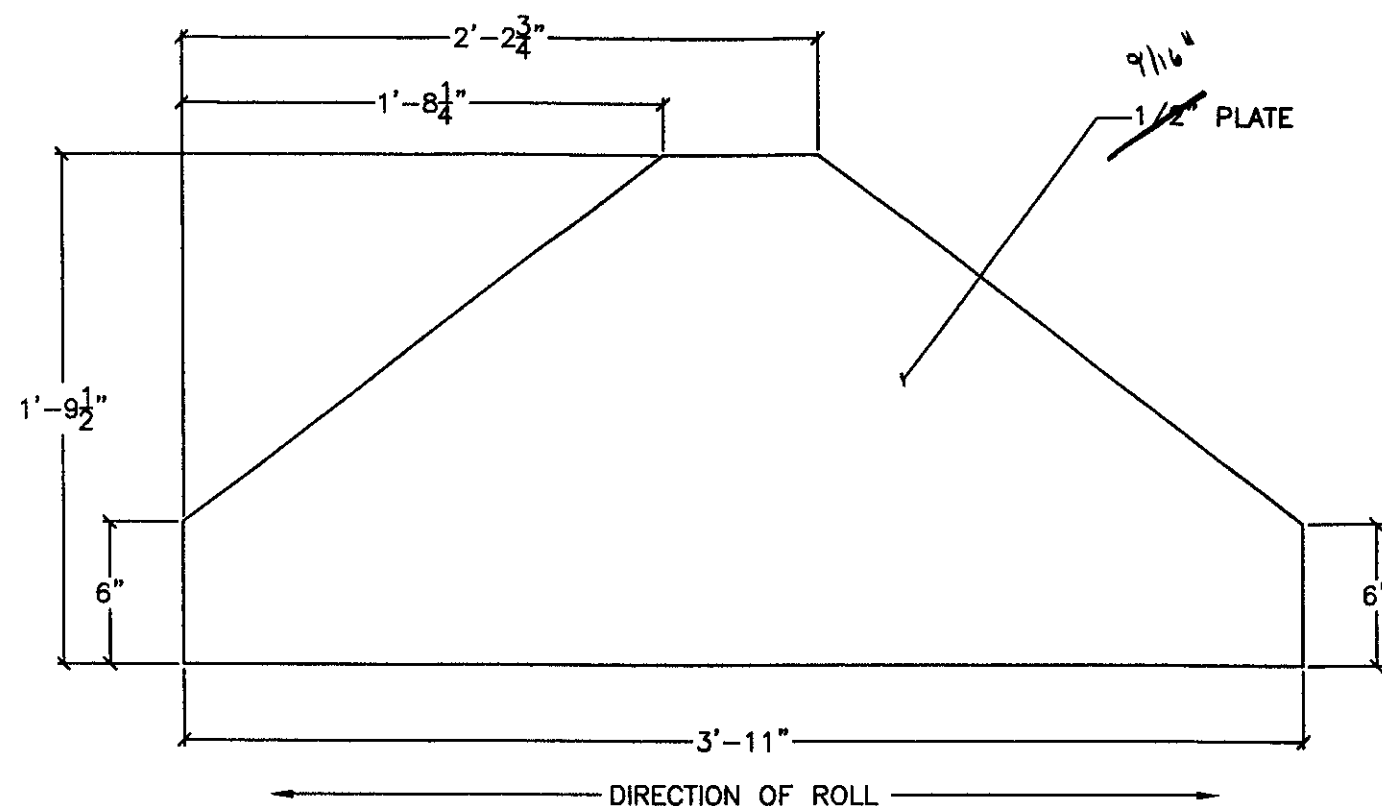

1GP04
3" = 1'-0"

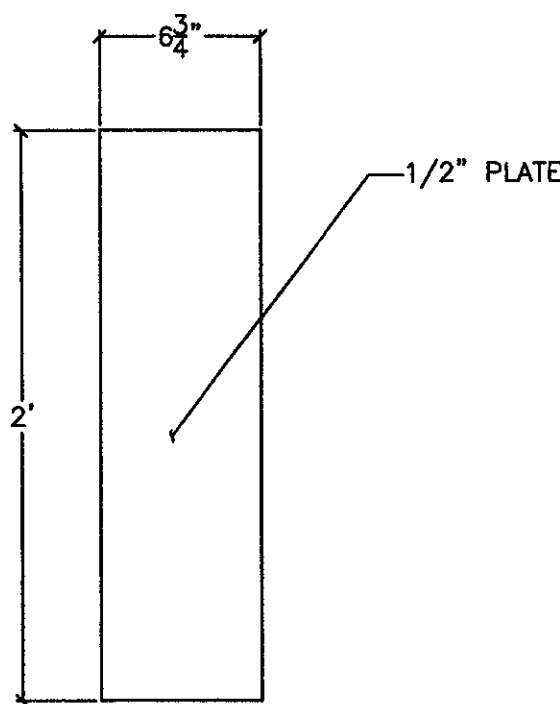

1GP05
3" = 1'-0"

RECEIVED
OK'D BY: CHM OK'D BY: _____
MAY 11 2009
BY: WJ DATE: 5/11/09

Renard Bros. Construction Fort Belknap Road, Helena, MT 59604 (406) 257-7383	
Wellington Bridge Rehab Wellington, VT	
PROJECT TITLE	Drawings Truss Type 1
DRAWN BY	JED
CHECKED BY	JED/AD
DATE	4/30/09
DRAWING NO.	T-1
SHEET NO.	17 OF 17