


GENERAL NOTES:


- * ALL MEASUREMENTS TO BE VERIFIED BEFORE FABRICATION OF INDIVIDUAL MEMBERS BEGINS
- * ALL HOLES DRILLED IN NEW FABRICATED STEEL, TO MATCH EXISTING STEEL MEMBERS
- * ALL STRUCTURAL STEEL SHALL CONFORM TO AASHTO M-270 GRADE 50
- * UNLESS OTHERWISE NOTED, ALL HOLES SHALL BE DRILLED TO $\frac{1}{8}$ " DIA
- * DIMENSIONS LESS THAN 25'-0" $\pm \frac{1}{8}$ "
- * DIMENSIONS GREATER THAN 25'-0" $\pm \frac{1}{4}$ "
- * SUPPORTING DOCUMENTATION TO DRAWINGS SEE BILL OF MATERIALS TRUSS TYPE 1 & 2.
- * ***PAINT SYSTEM TO BE USED.***

BEARING PEDESTAL:

NOTE: HORIZONTAL LATERAL BRACING / FLOOR BEAM CONNECTION PLATES, SCHEDULED FOR REPLACEMENT AT L0, L2, L4, L6 & L8 ARE NOT INCLUDED IN THIS SET.

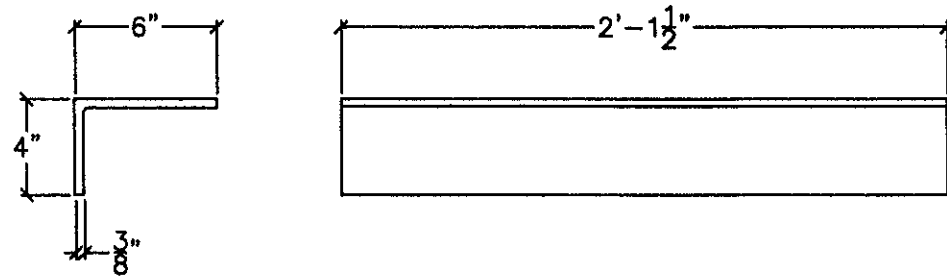

2BP01-ANGLE
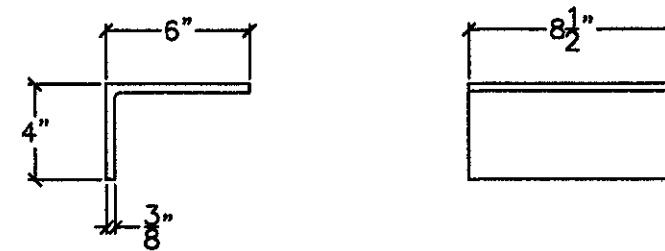
$$3'' = 1' - 0''$$


2BP03-ANGLE

$$3'' = 1' - 0''$$

**NOTE: FOR FUTURE SUBMITTALS
PLEASE PROVIDE BILL OF
MATERIALS, INCLUDING
FASTENERS, ON THE SHEETS
WITH DETAILS.**

RECEIVED
CK'D BY CWA OK'D BY _____
MAY 11 2009
RE-SUBMIT _____ APPROVED As Noted
BY SA DATE 5/14/09
why

Renaud Bros. Construction
Fort Bridgman Road Vernon, VT 05354
(802) 257 - 7383

Bridge Rehab
VT

DRAWING TITLE
Drawings Truss Type 2- General Notes & Drawings

DRAWN BY	JED	JOB CONTACT	Erick Foster State of VT
----------	-----	-------------	--------------------------

DRAWN BY	JED	JOB	CONTACT	ENCL
CHECKED BY	JED/AD	DATE	4 30 09	

DRAWING NO.

T-2

1 OF 18