



BEARING PEDESTAL CONT.:

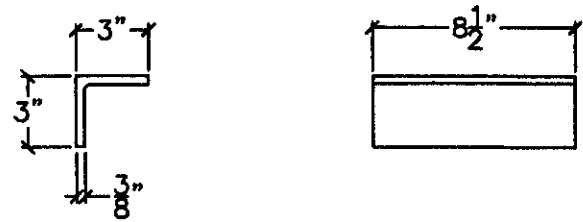


2BP04-ANGLE

3" = 1'-0"

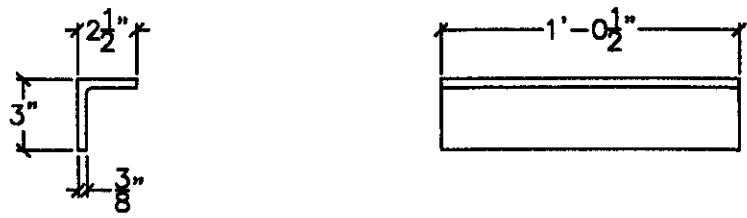


2BP05-ANGLE

3" = 1'-0"

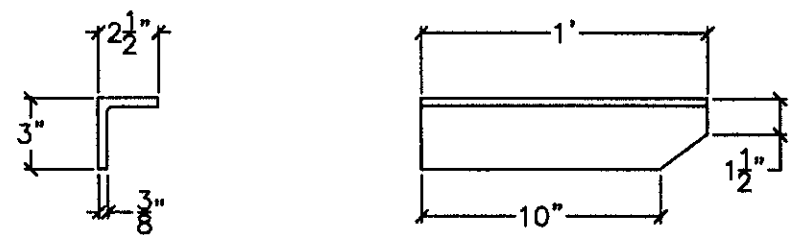

2BP06R-ANGLE

3" = 1'-0"

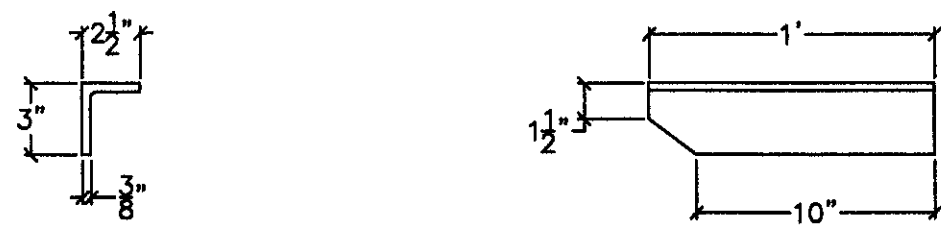

2BP06L-ANGLE

3" = 1'-0"

RECEIVED
OK'D BY CWA OK'D BY _____
MAY 11 2009
R. SUEWIT _____ APPROVED As WJ
BY WJ DATE 5/1/09

Pineau Bros. Construction Pineau Bros. Construction (802) 257-7893	
TITLE: Wallingford Bridge Rehab LOCATION: Wallingford, VT DRAWING TITLE: Drawings Truss Type 2: Drawings DRAWN BY: JED JOB CONTACT: Erick Foster State of VT CHECKED BY: JED/AD DATE: 4.30.09	
DRAWING NO.	T-2
SHEET NO.	2 of 18