



BEARING PEDESTAL CONT.:

TBD WHEN REMOVED
DWG. SUBMITTED FOR
APPROVAL

2BP07-PLATE
3" = 1'-0"

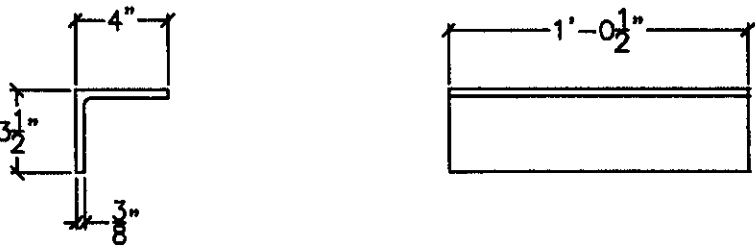

2BA01-ANGLE
3" = 1'-0"

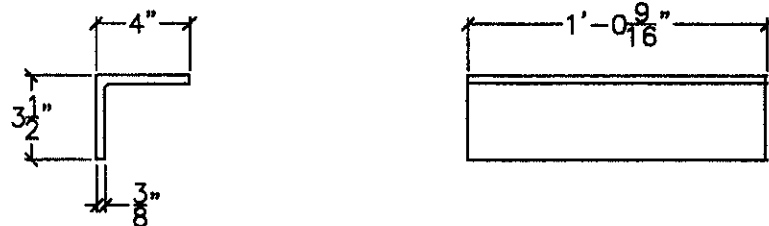

2BA02-ANGLE
3" = 1'-0"

RECEIVED
OK'D BY CHS OK'D BY _____
MAY 11 2009
R. SUEWIT _____ APPROVED As WY
BY WY DATE 5/11/09

Renaud Bros. Construction Renaud Bros. Construction (802) 257-1285	
Wallingford Bridge Rehab Wallingford, VT	
DRAWING TITLE Drawings Truss Type 2: Drawings	
DRAWN BY: JED	JOB CONTACT: Erick Foster State of VT
CHECKED BY: JED/AD	DATE: 4-30-09
DRAWING NO.	
T-2	
SHEET NO.	
3 of 18	