



LATTICE:

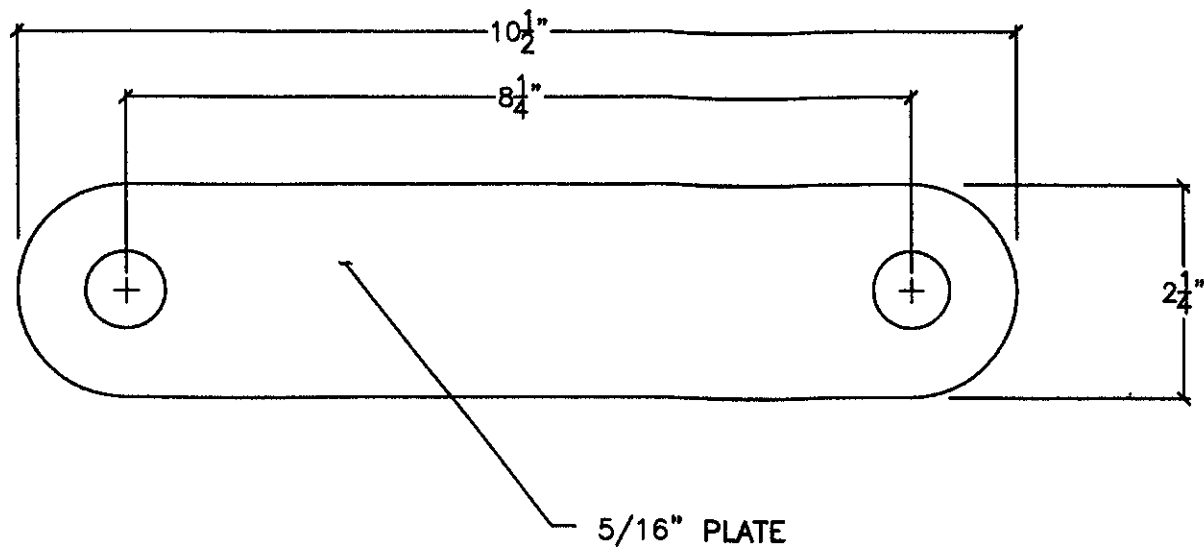

2LP01-PLATE

3" = 1'-0"

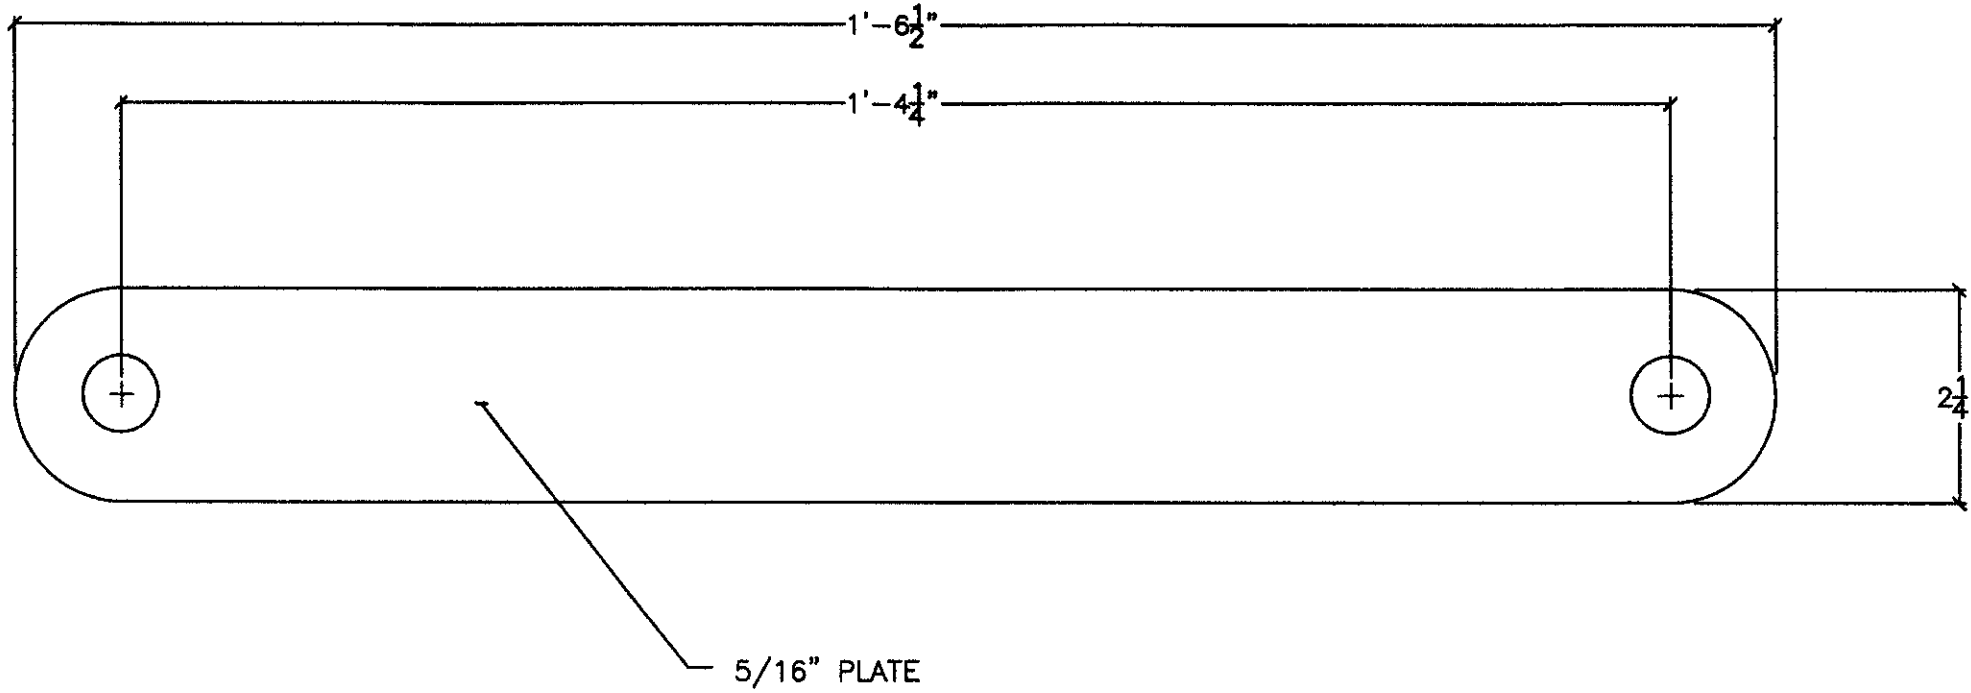

2LP02-ANGLE

3" = 1'-0"

RECEIVED
CK'D BY CW OK'D BY _____
MAY 11 2009
R SUBMIT _____ APPROVED As Noted
BY WY 5/11 DATE 5/11/09

Pineau Bros. Construction Pineau Bros. Construction (802) 257-7383	
Wallingford Bridge Rehab Wallingford, VT	
DRAWING TITLE	Drawings Truss Type 2: Drawings
DRAWN BY	JED
CHECKED BY	ED/AD
DATE	4 30 09
DRAWING NO.	T-2
SHEET NO.	4 OF 18