




UPRIGHT MEMBERS:

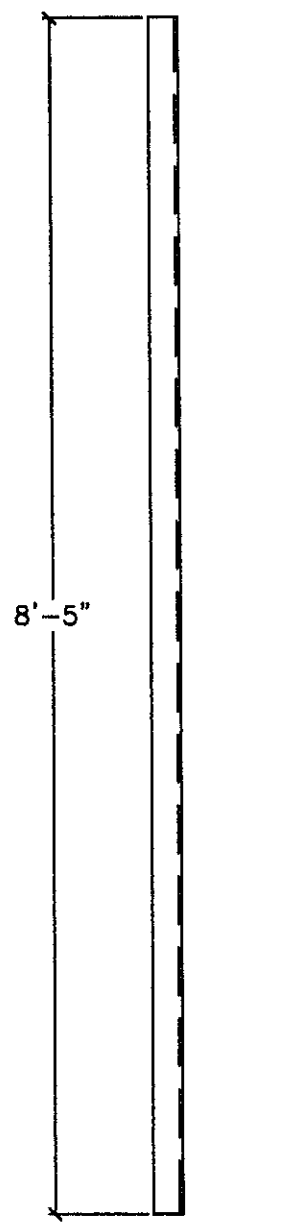

2U1L1L-ANGLE
1-1/2" = 1'-0"

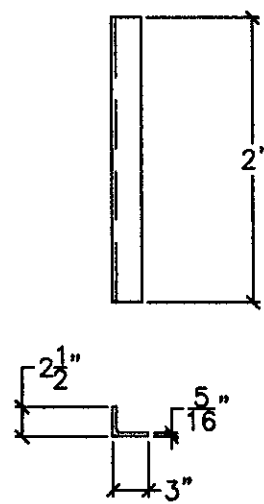

2U1L1R-ANGLE
1-1/2" = 1'-0"

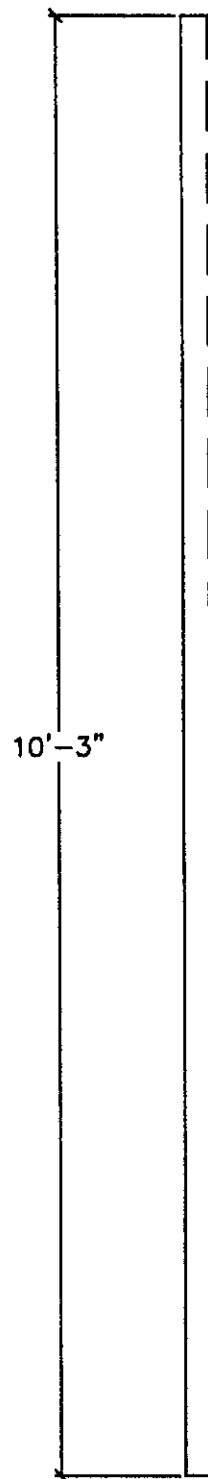

2U2L2L-ANGLE
1-1/2" = 1'-0"

RECEIVED
CK'D BY CHB OK'D BY _____
MAY 11 2013
R. L. G. MIT APPROVED As Noted
BY WJ DATE 5/16/13

FILE	LOCATION	Wallingford Bridge Rehab	Renard Bros. Construction Renard, Vermont 05068 (802) 257-7285
DRAWING TITLE	Wallingford, VT		
DRAWN BY	JED	JOB CONTACT	Ernst Foster State of VT
CHECKED BY	JED/AD	DATE	4 30 09
DRAWING NO.	T-2		
SHEET NO.	6 of 18		