

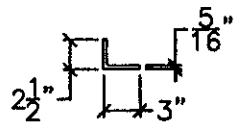
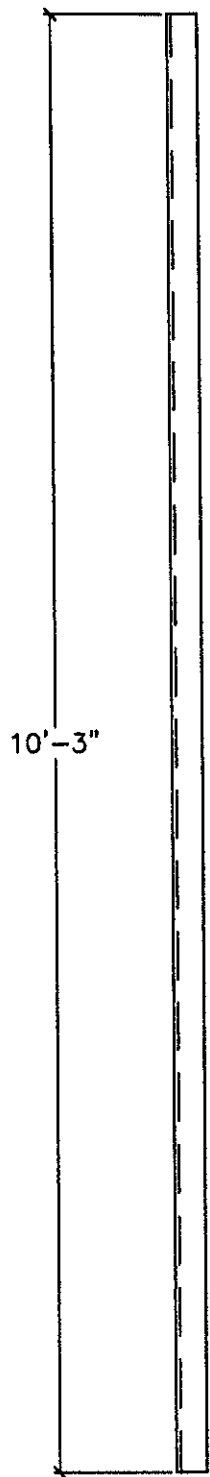




UPRIGHT MEMBERS:

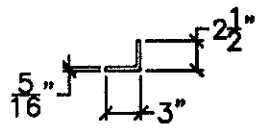

**2U2L2R-ANGLE**  
1-1/2" = 1'-0"

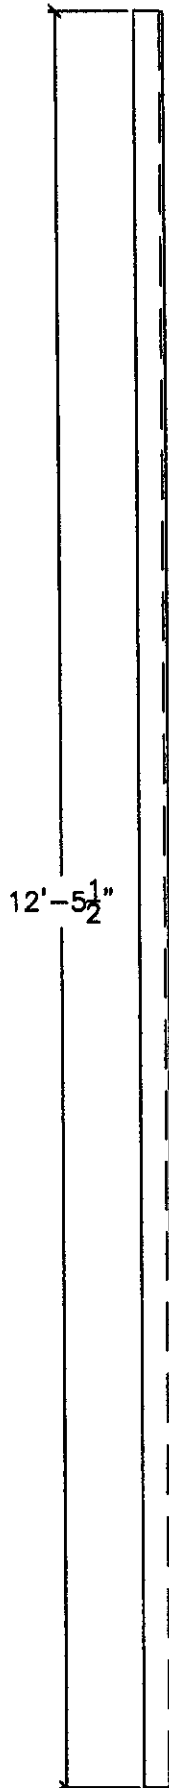

**2U3L3L-ANGLE**  
1-1/2" = 1'-0"

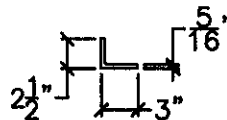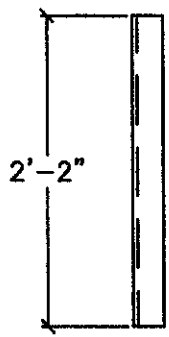

**2U3L3R-ANGLE**  
1-1/2" = 1'-0"

RECEIVED  
CK'D BY CMB OK'D BY \_\_\_\_\_  
MAY 11 2009  
BY WJ DATE 5/11/09  
APPROVED As Noted

|                                                  |  |                                                                       |  |
|--------------------------------------------------|--|-----------------------------------------------------------------------|--|
| TITLE<br>Wallingford Bridge Rehab                |  | REHAUD ERS Construction<br>Rt. 100, Wallingford, VT<br>(802) 257-7393 |  |
| LOCATION<br>Wallingford, VT                      |  |                                                                       |  |
| DRAWING TITLE<br>Drawings Truss Type 2: Drawings |  |                                                                       |  |
| DRAWN BY<br>JED                                  |  | JOB CONTACT<br>Erick Foster State of VT                               |  |
| CHECKED BY<br>JED/AD                             |  | DATE<br>4 30 09                                                       |  |
| DRAWING NO.                                      |  | T-2                                                                   |  |
| SHEET NO.                                        |  | 7 of 18                                                               |  |