

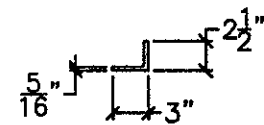
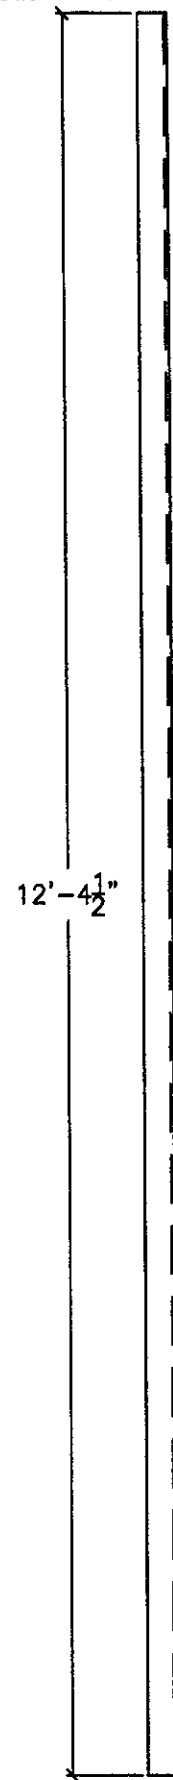


UPRIGHT MEMBERS:

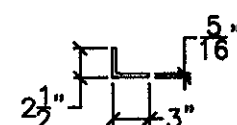



2U4L4L-ANGLE

1-1/2" = 1'-0"

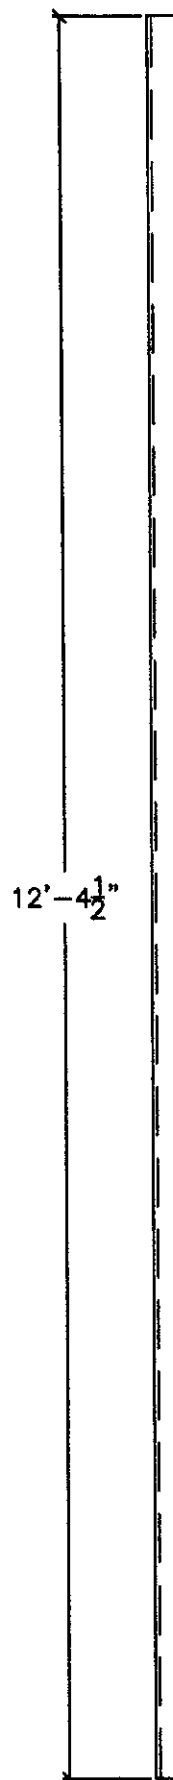

2U4L4R-ANGLE

1-1/2" = 1'-0"

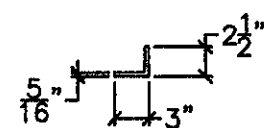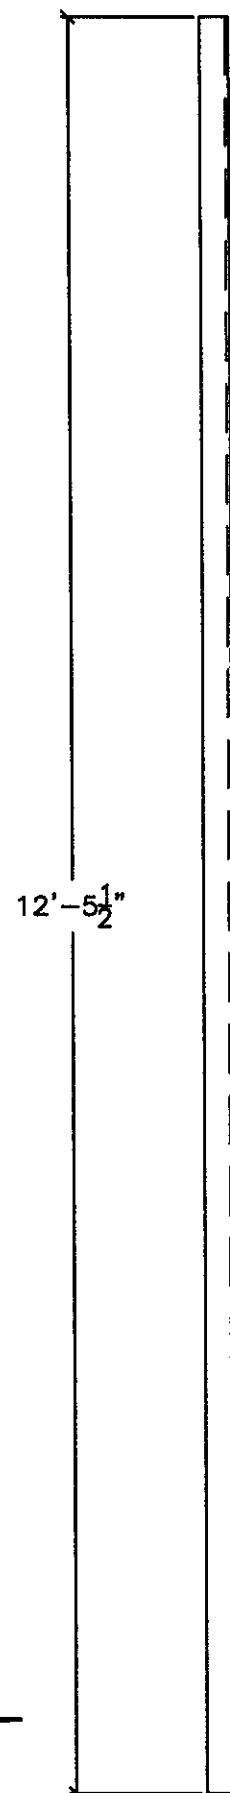

2U5L5L-ANGLE

1-1/2" = 1'-0"

RECEIVED
OK'D BY CJA OK'D BY _____
MAY 1 1 2009
BY WJ DATE 5/1/09
APPROVED AS

FILE	Wallingford Bridge Rehab	Renald Bros Construction
LOCATION	Wallingford, VT	Renald Bros Construction
DRAWING TITLE	Drawings Truss Type 2: Drawings	Renald Bros Construction
DRAWN BY	JED	Renald Bros Construction
CHECKED BY	JED/AD	Renald Bros Construction
DATE	4 30 09	Renald Bros Construction
JOB CONTACT	Ernst Foster State of VT	Renald Bros Construction
DATE	4 30 09	Renald Bros Construction
DRAWING NO.	T-2	Renald Bros Construction
SHEET NO.	8 of 18	Renald Bros Construction