



UPRIGHT MEMBERS:

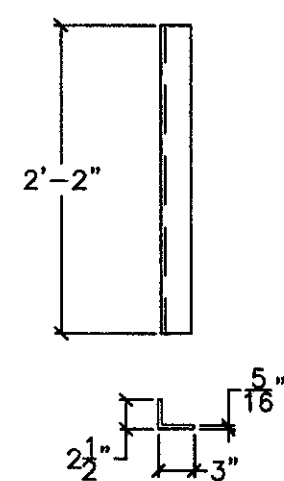


2U5L5R-ANGLE
1-1/2" = 1'-0"

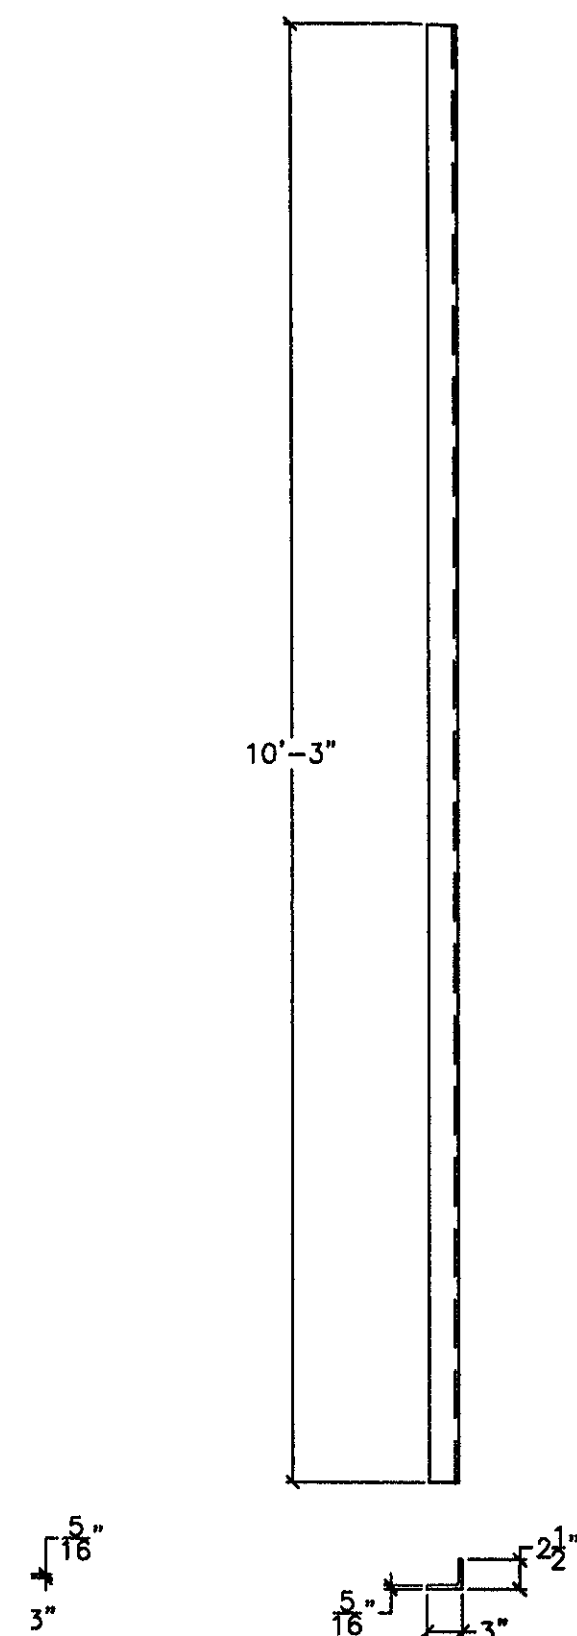

2U6L6L-ANGLE
1-1/2" = 1'-0"

RECEIVED
CK'D BY CHA OK'D BY _____
MAY 11 2009
R. G. ENIT. _____ APPROVED As not
BY sf DATE 5/29/09
WY

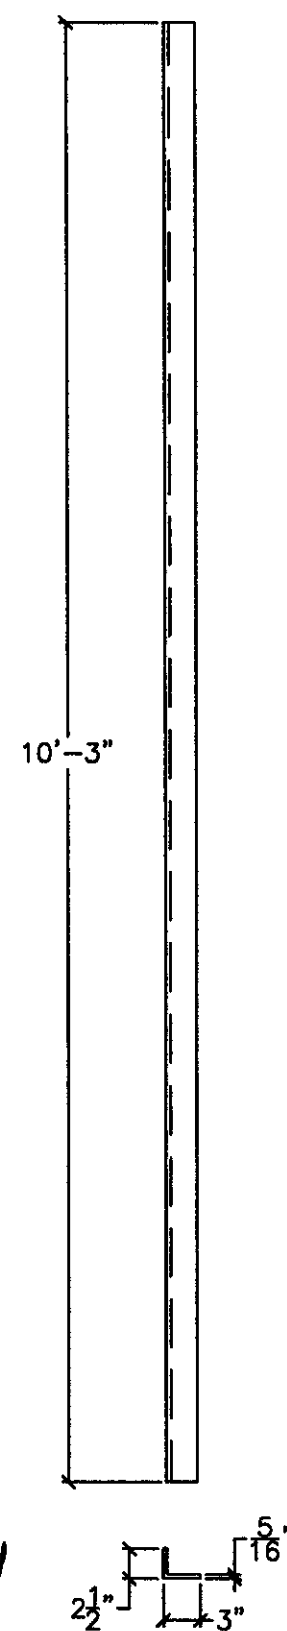

2U6L6R-ANGLE
1-1/2" = 1'-0"

SHEET NO.	DRAWING NO.		Renaud Bros. Construction 1400 Main Street Wallingford, VT 05693 (502) 257-7185
	TITLE		
	LOCATION		
	DRAWING TITLE		
	DRAWN BY	JED	
T-2 9 of 18			