

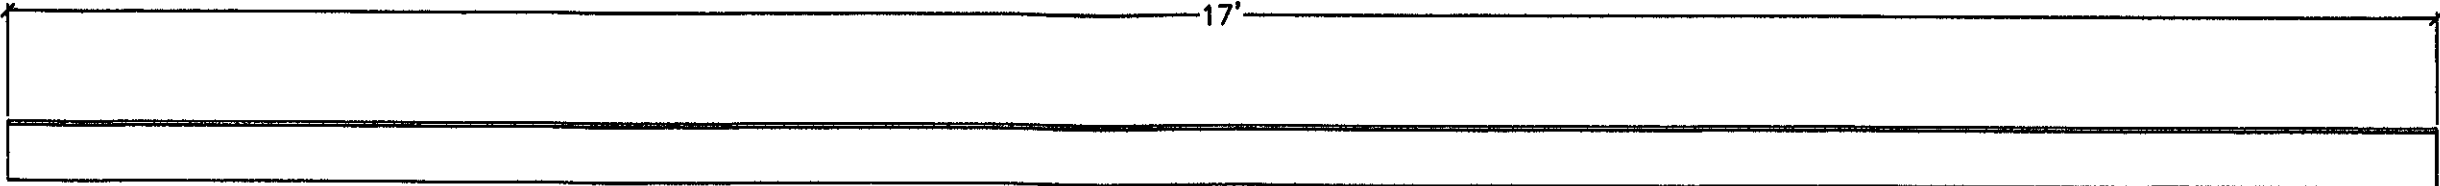
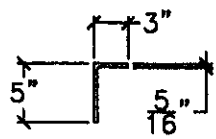


UPRIGHT MEMBERS:

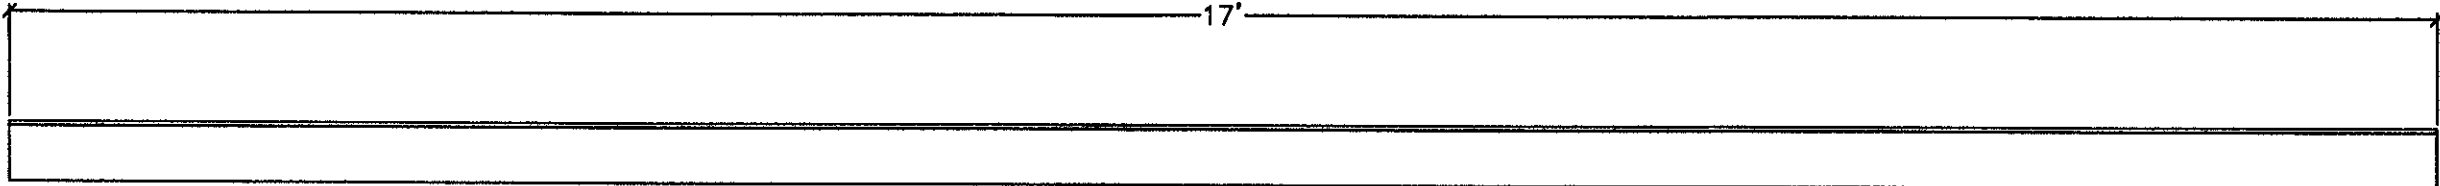

2DMO1-ANGLE
1-1/2" = 1'-0"

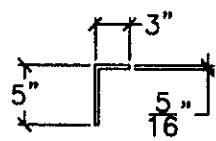

2DMO2-ANGLE
1-1/2" = 1'-0"

RECEIVED
CHK'D BY CHA OK'D BY _____
MAY 11 2009
BY WY DATE 5/11/09
APPROVED As Noted

Renaud Bros. Construction Pellissee, New York, 11958 (607) 257-7300	
TITLE: Wallingford Bridge Rehab	
LOCATION: Wallingford, VT	DRAWING TITLE: Drawings Truss Type 2 Drawings
DRAWN BY: JED	JOB CONTACT: Erick Foster State of VT
CHECKED BY: JED/AD	DATE: 4.30.09
DRAWING NO. T-2	
SHEET NO. 10 OF 18	