

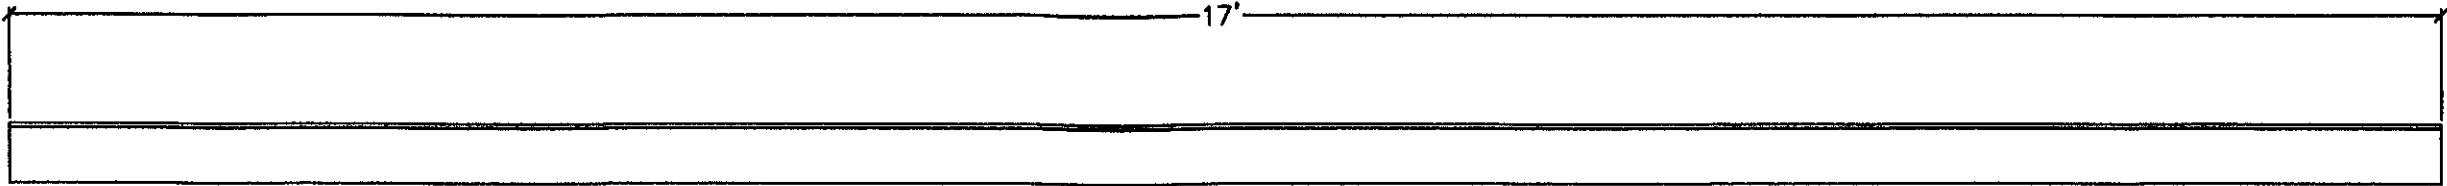
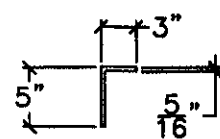


UPRIGHT MEMBERS:

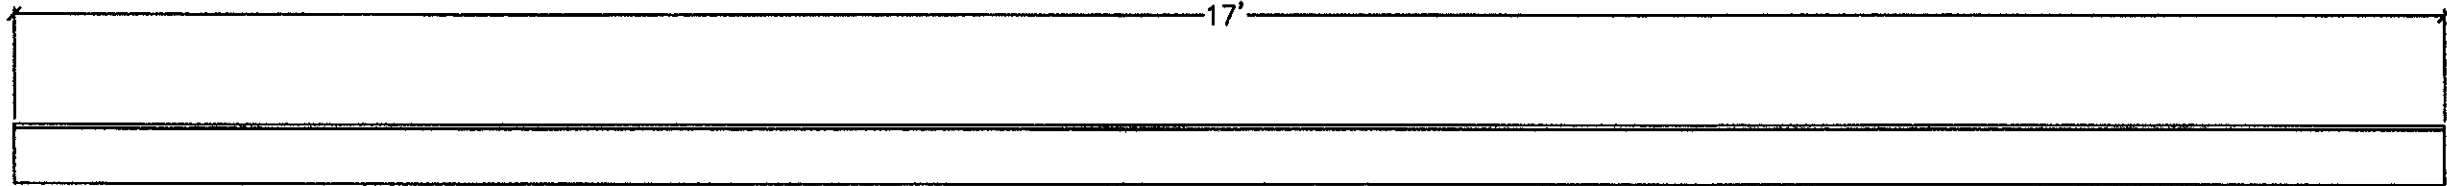

2DMO3-ANGLE
1-1/2" = 1'-0"

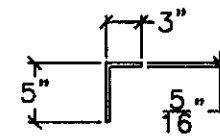

2DMO4-ANGLE
1-1/2" = 1'-0"

RECEIVED
CHK'D BY CHA OK'D BY _____
MAY 11 2009
BY WJ DATE 5/19/09
APPROVED A. [Signature]

Renaud Bros. Construction Hartford, Vermont (802) 257-1338	
Wallingford Bridge Rehab Wallingford, VT	
DRAWING TITLE Drawings Truss Type 2: Drawings	
DRAWN BY	JED
JOB CONTACT	Erick Foster State of VT
CHECKED BY	JED/AD
DATE	4 30 09
DRAWING NO.	
T-2	
SHEET NO.	
11 of 18	