


UPRIGHT MEMBERS:

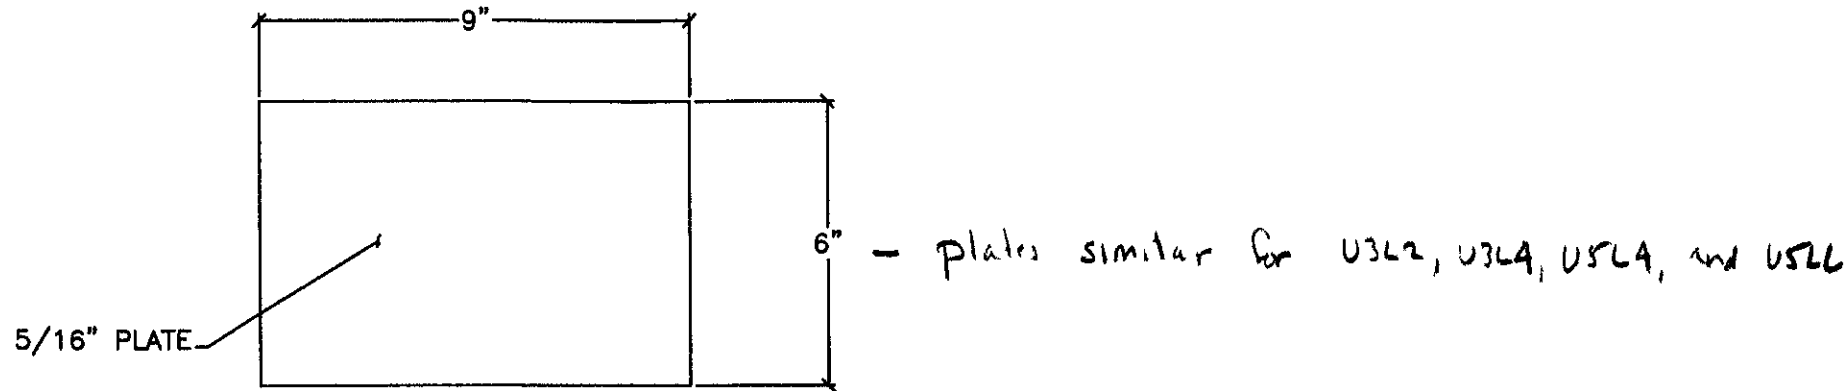

2DM05-PLATE
6" = 1'-0"

RECEIVED
CK'D BY CHA CK'D BY _____
MAY 11 2009
R. GENTILE APPROVED As NW
BY SA DATE 5/4/09
WY

FILE		Wallington Bridge Rehab		Reinforced Construction	
LOCATION		Wallington, VT		Reinforced Construction	
DRAWING TITLE		Drawings Truss Type 2. Drawings		(802) 257-7383	
DRAWN BY		JED	JOB CONTACT	Erick Foster State of VT	
CHECKED BY		JED/AD	DATE	4 30 09	
DRAWING NO.		T-2			
SHEET NO.		12 of 18			