



BOTTOM CHORD:

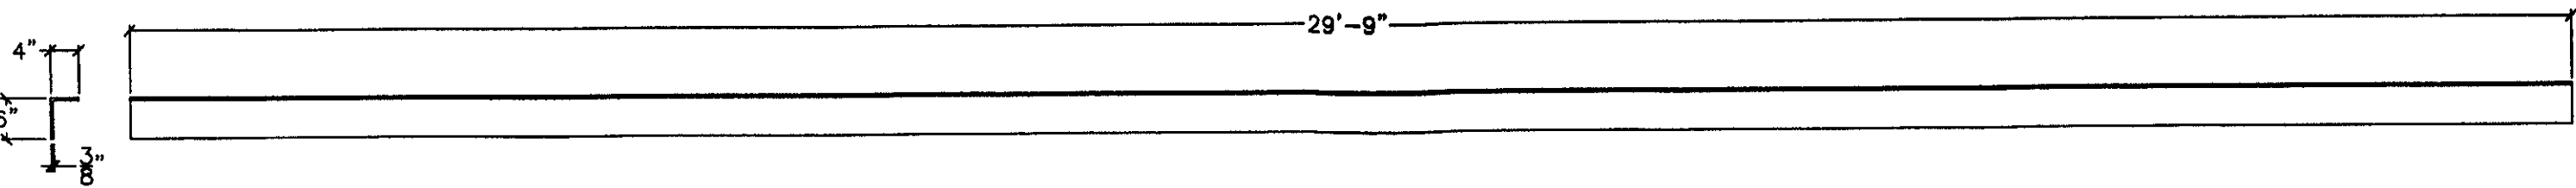


2L0L2A-ANGLE

1" = 1'-0"

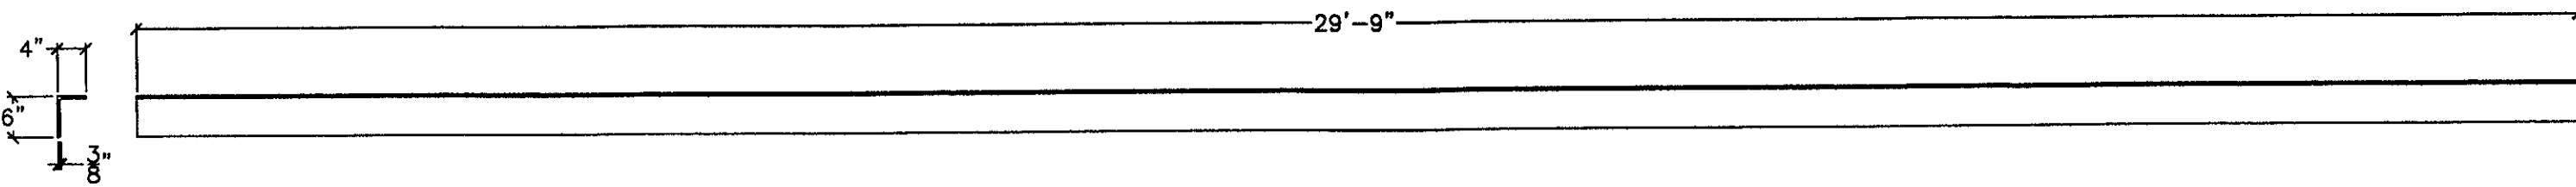

2L0L2B-ANGLE

1" = 1'-0"

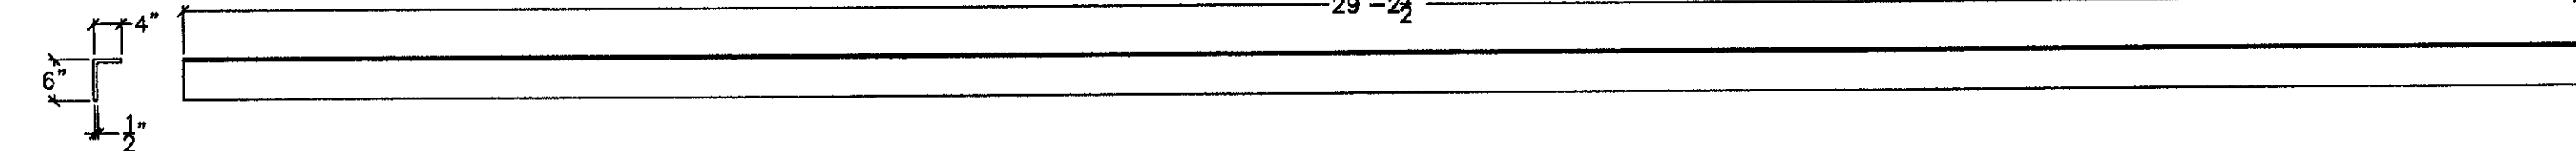

2L2L4A-ANGLE

1" = 1'-0"

RECEIVED
CK'D BY CJA CK'D BY _____
MAY 11 2011
R. J. G. H. T. APPROVED BS
BY WY DATE 5/19/11

Pineau Bros. Construction Rutland, VT 05701 (802) 257-7383	
TITLE: Wallingford Bridge Rehab LOCATION: Wallingford, VT DRAWING TITLE: Drawings Truss Type 2 Drawings DRAWN BY: JED CHECKED BY: JED/AD DATE: 4-30-09	
JOB CONTACT: Erick Foster State of VT	
DRAWING NO.: T-2	
SHEET NO.: 13 of 18	