



BOTTOM CHORD:

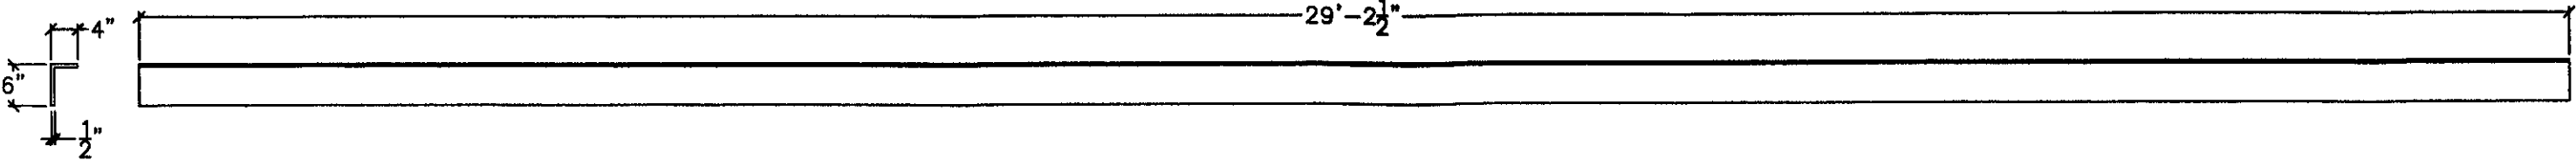

2L4L6A-ANGLE

1" = 1'-0"

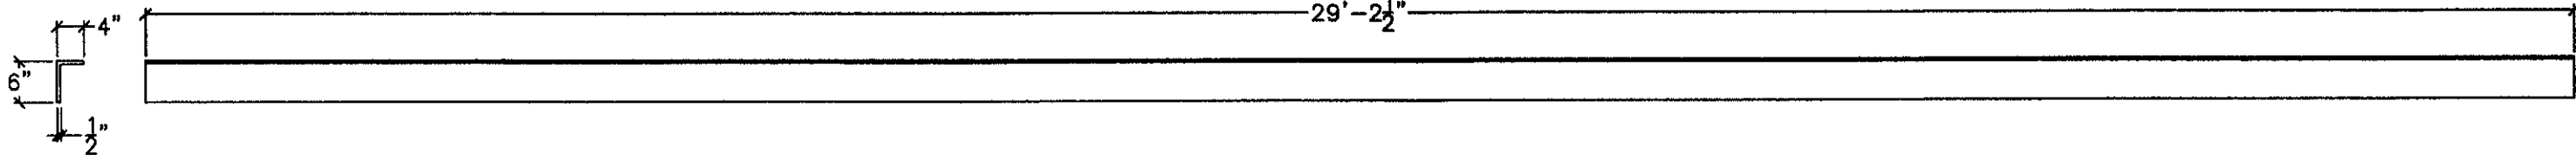

2L4L6B-ANGLE

1" = 1'-0"

RECEIVED
CK'D BY CWA OK'D BY _____

MAY 11 2014
APPROVED As Noted
BY WY DATE 5/11/14

Pineau Bros. Construction Pineau Bros. Construction (802) 257-7393	
FILE	Wallingford Bridge Rehab
LOCATION	Wallingford, VT
DRAWING TITLE	Drawings Truss Type 2: Drawings
DRAWN BY	JED
JOB CONTACT	Erik Foster State of VT
CHECKED BY	JED/AD
DATE	4 30 09
DRAWING NO.	T-2
SHEET NO.	14 of 18