



BOTTOM CHORD:

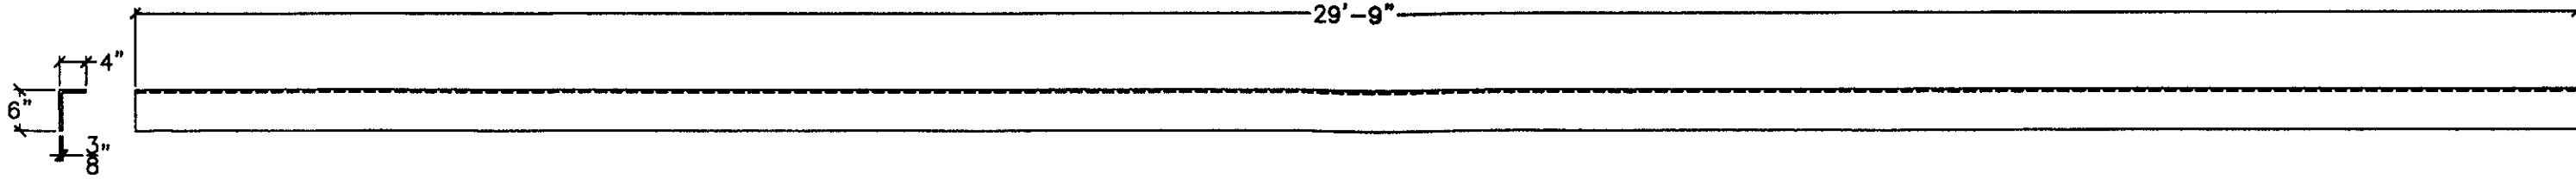

2L6L8A-ANGLE

1-1/2" = 1'-0"

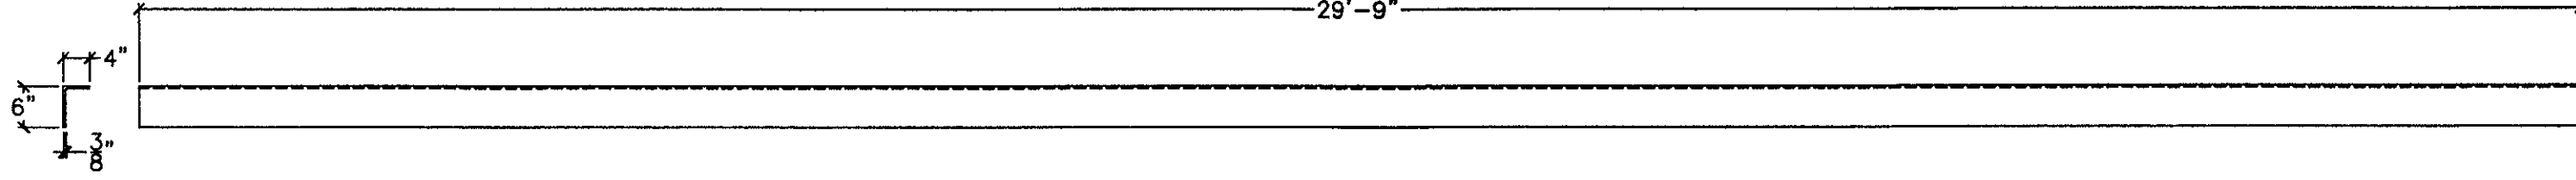

2L6L8B-ANGLE

1" = 1'-0"

RECEIVED
OK'D BY CHA OK'D BY _____
MAY 11 2009
RESUBMIT _____ APPROVED As WY
BY WY SP DATE 5/14/09

Pineau Bros Construction Pineau, Vermont (802) 257-7383	
TITLE: Wallingford Bridge Rehab LOCATION: Wallingford, VT	
DRAWING TITLE: Drawings Truss Type 2 Drawings	
DRAWN BY: JED	JOB CONTACT: Erick Foster State of VT
CHECKED BY: JED/AD	DATE: 4 30 09
DRAWING NO. T-2	
SHEET NO. 15 of 18	