


BOTTOM CHORD:

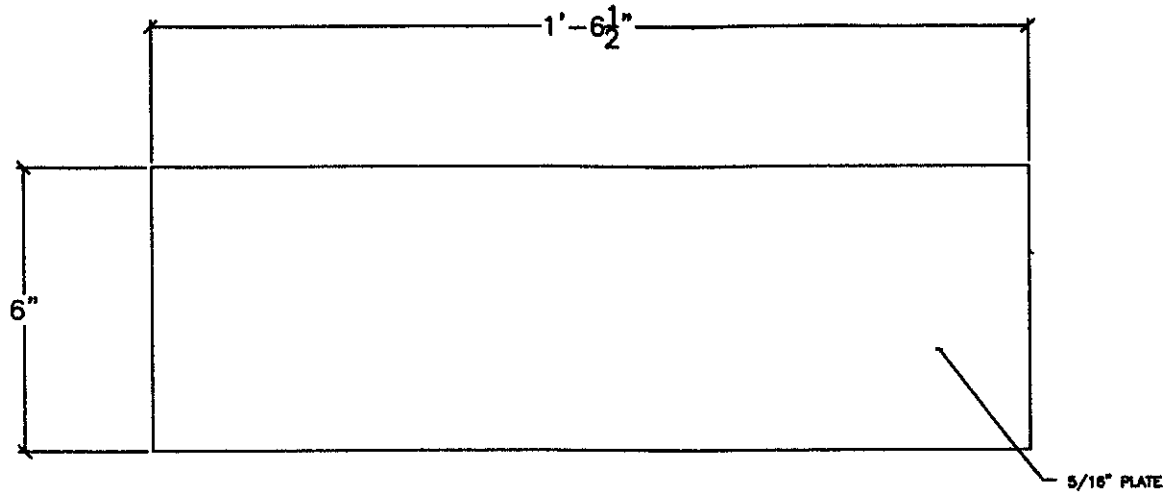

2BC01-PLATE

3" = 1'-0"

RECEIVED
CK'D BY CWH OK'D BY _____
MAY 11 2009
RESUBMIT _____ APPROVED AS NCH
BY WY 3/1 DATE 5/11/09

TITLE		Wallingford Bridge Rehab	
LOCATION		Wallingford, VT	
DRAWING TITLE		Drawings Truss Type 2: Drawings	
DRAWN BY	JED	JOB CONTACT	Erick Foster State of VT
CHECKED BY	JED/AD	DATE	4 30 08
DRAWING NO.		T-2	
SHEET NO.		16 of 18	

Renard Bros. Construction
Renard Bros. Construction
(802) 257-7353