


GUSSET PLATES.:

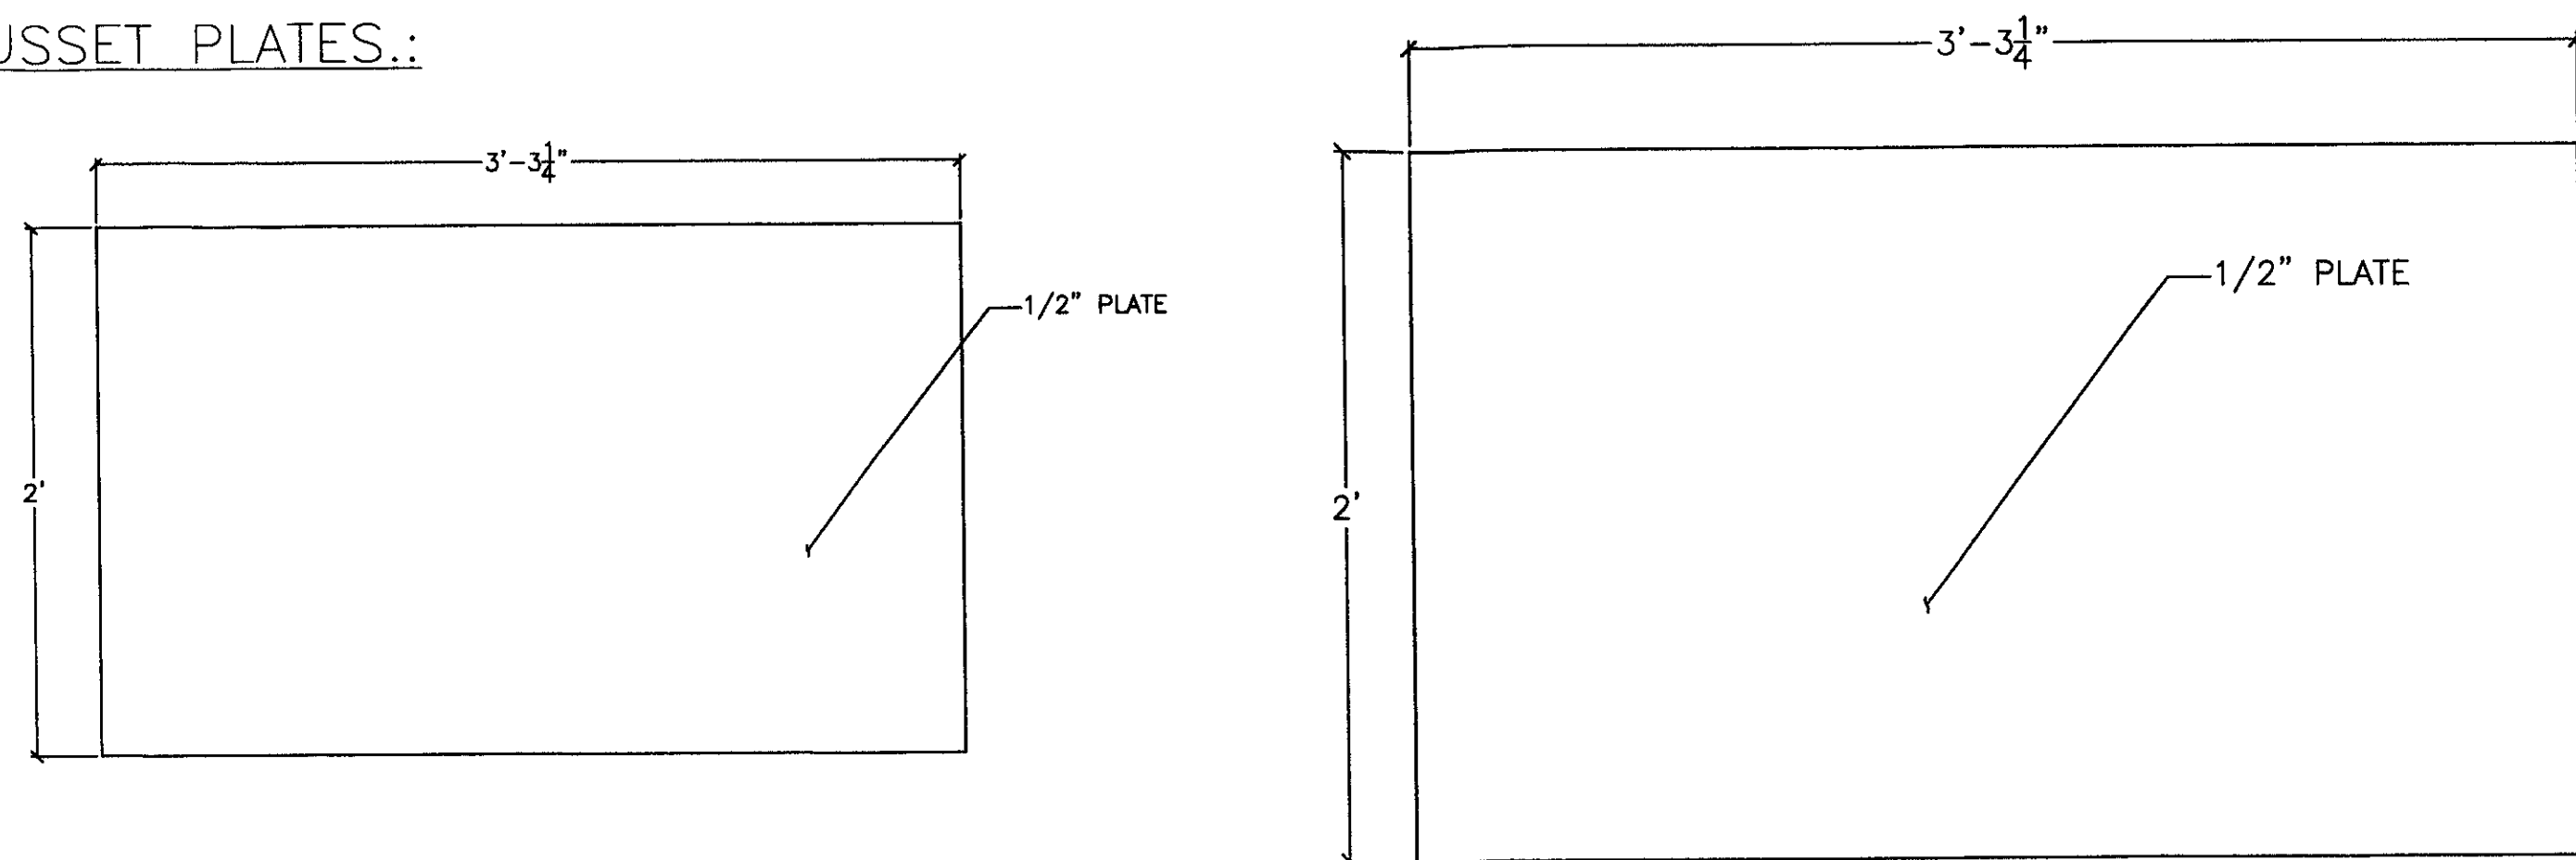


2GP01-PLATE

3" = 1'-0"

2GP02-PLATE

3" = 1'-0"

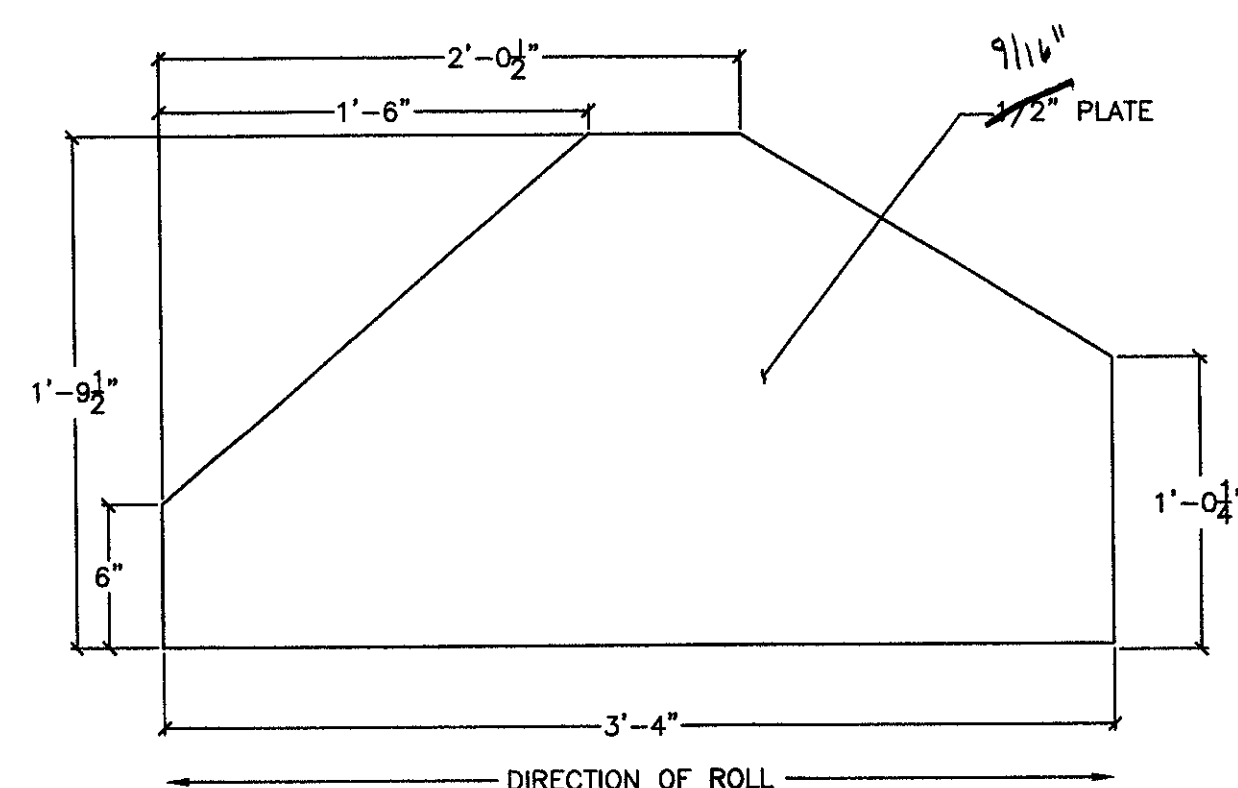

2GP03-PLATE

3" = 1'-0"

RECEIVED  
CK'D BY CHH OK'D BY \_\_\_\_\_  
MAY 11 2009  
R/SUBMIT \_\_\_\_\_ APPROVED AS AW  
BY WY 9 DATE 5/11/09

|                                                               |                                |
|---------------------------------------------------------------|--------------------------------|
| Renard Bros. Construction<br>Reno, VT 05460<br>(802) 257-7383 |                                |
| Wallingford Bridge Rehab<br>Wallingford, VT                   |                                |
| DRAWING TITLE                                                 | Drawings Truss Type 2 Drawings |
| DRAWN BY                                                      | JED                            |
| CHECKED BY                                                    | JED/AD                         |
| DATE                                                          | 4 30 09                        |
| T-2                                                           |                                |
| 17 of 18                                                      |                                |