



GUSSET PLATES.:

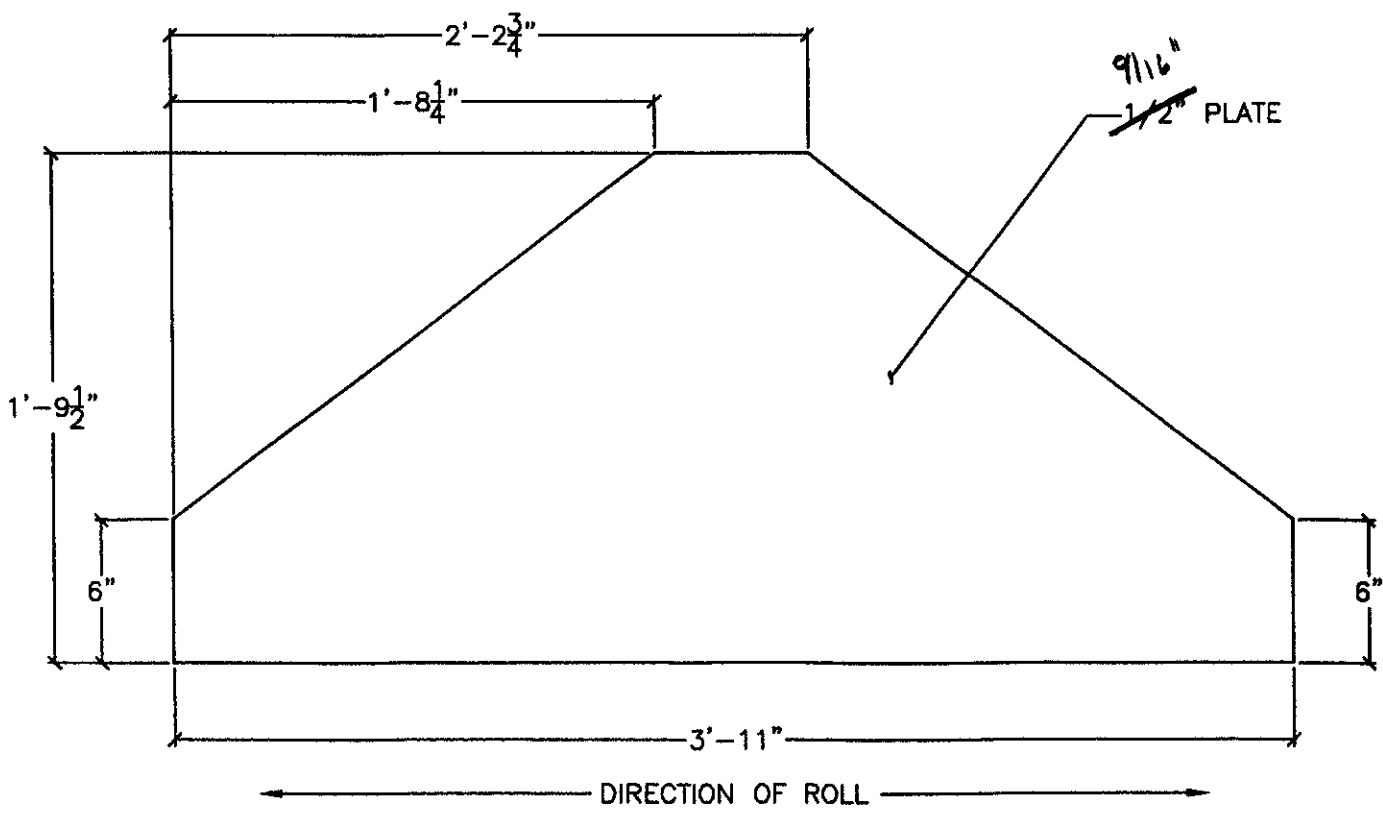

2GP04-PLATE
3" = 1'-0"

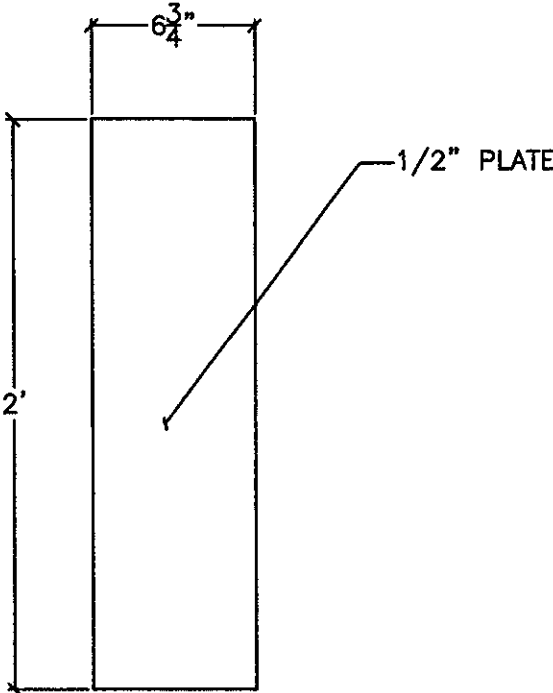

2GP05-PLATE
3" = 1'-0"

RECEIVED
CHK'D BY CJM OK'D BY _____
MAY 11 2009
RF SUBMIT _____ APPROVED As Noted
BY WY 9/1 DATE 5/14/09

Renaud Bros. Construction P.O. Box 1000 Wallingford, VT 05793 (802) 257-1235	
TITLE	Wallingford Bridge Rehab
LOCATION	Wallingford, VT
DRAWING TITLE	Drawings Truss Type 2 Drawings
DRAWN BY	JED
CHECKED BY	JED/AO
JOB CONTRACT	Erick Foster State of VT
DATE	4.30.09
DRAWING NO.	T-2
SHEET NO.	18 of 18