



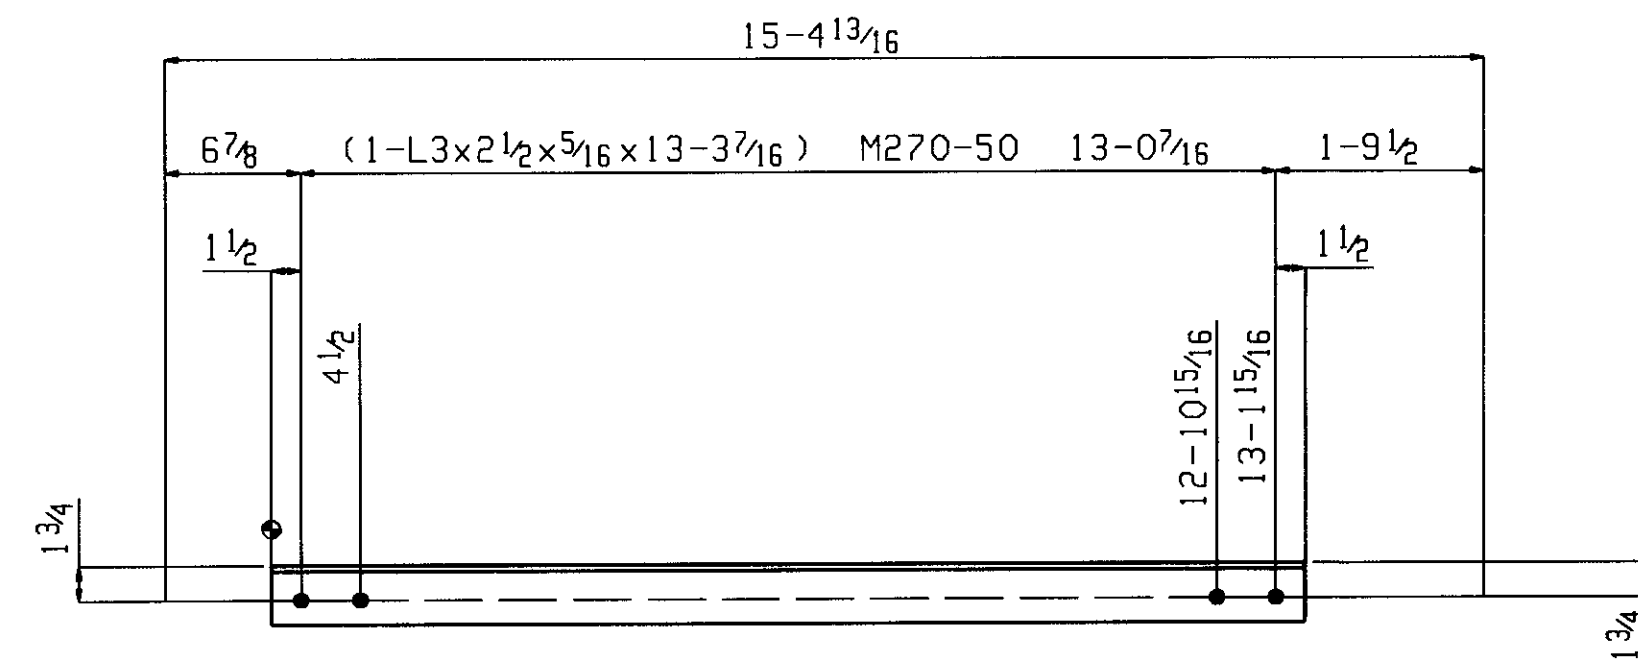

8 HORIZONTAL BRACES HB1


SHOP NOTE
TOE DIRECTION NEAR SIDE
LONG LEG SHOWN

DATE 6/3/09 BY [Signature]
CLD GH HARBOUR & ASSOCIATES LLP
ENGINEERS ARCHITECTS & LANDSCAPE ARCHITECTS

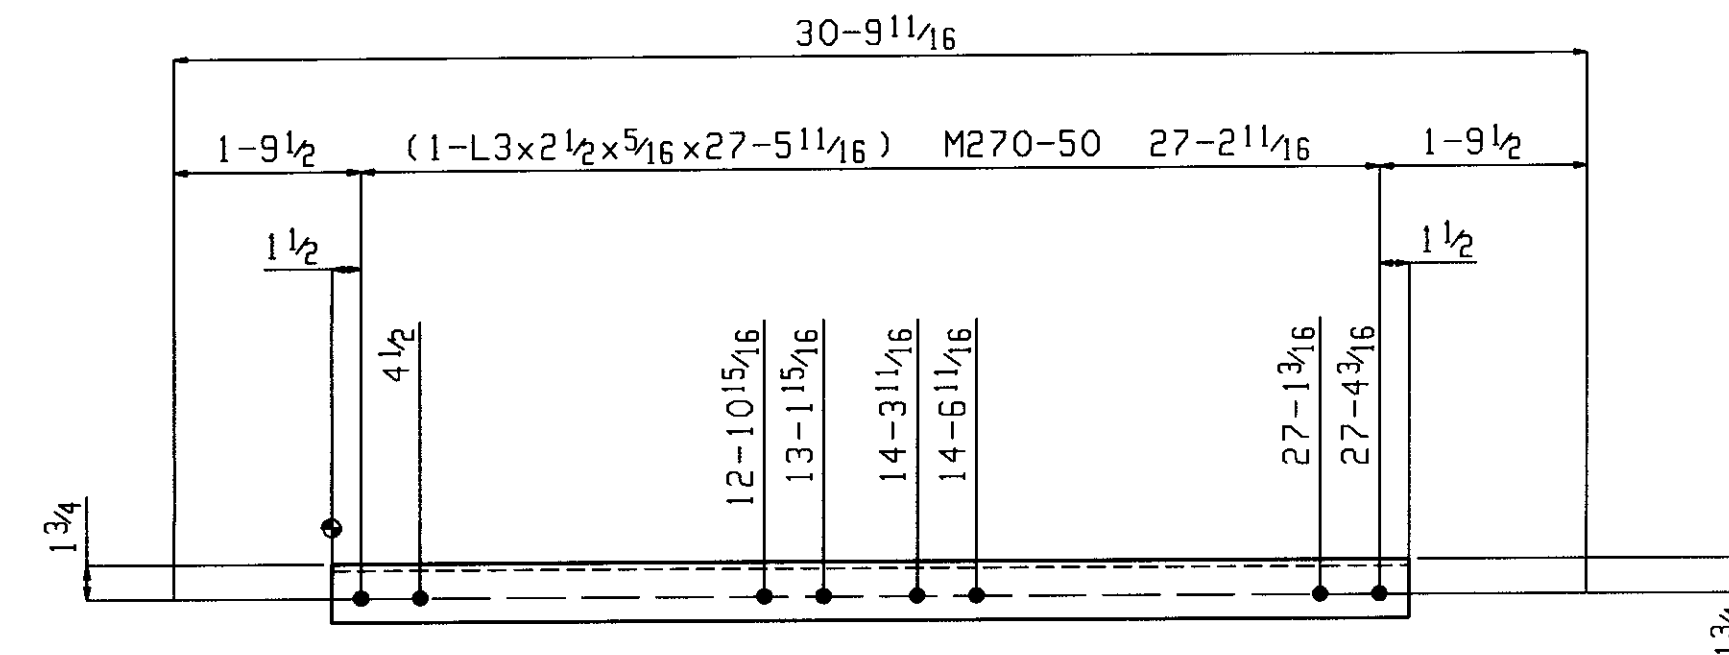


4 HORIZONTAL BRACES HB2


SHOP NOTE:
TOE DIRECTION FAR SIDE
LONG LEG SHOWN

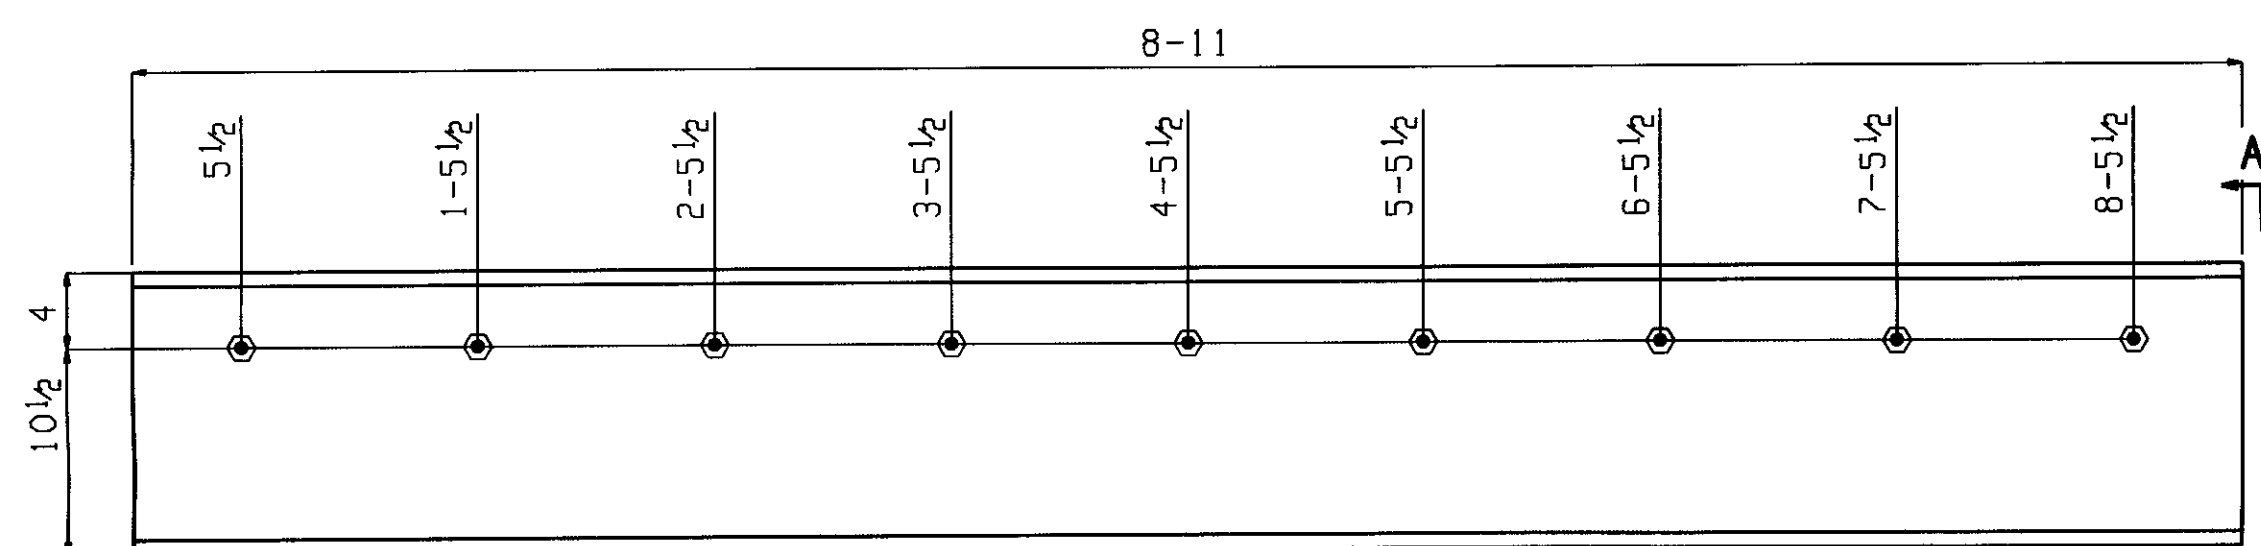


ONE MISC M1 GALV

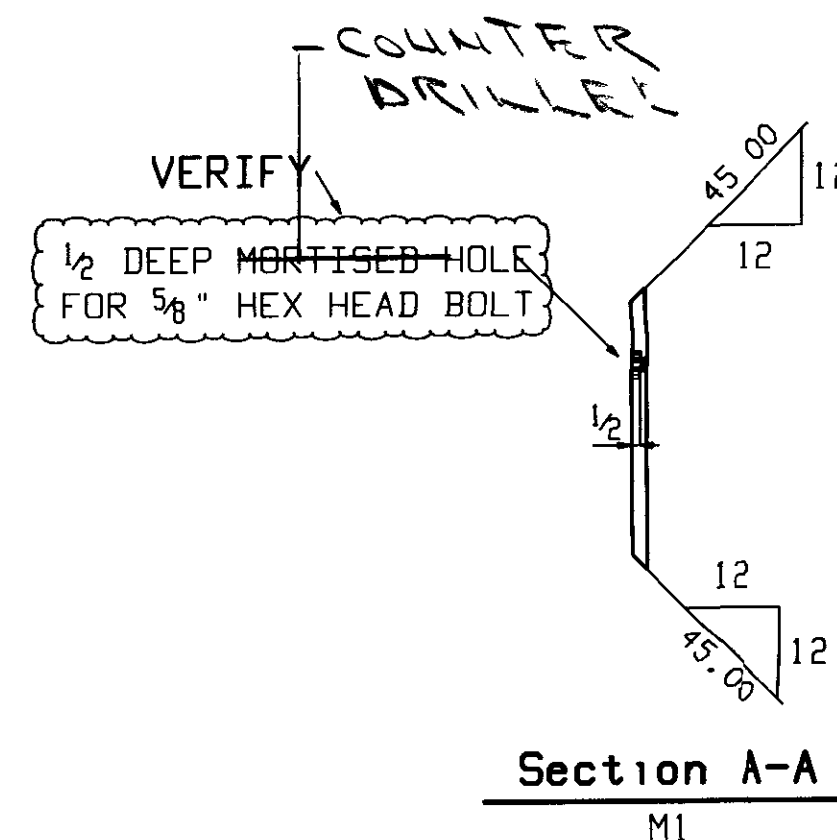

Section A-A M1

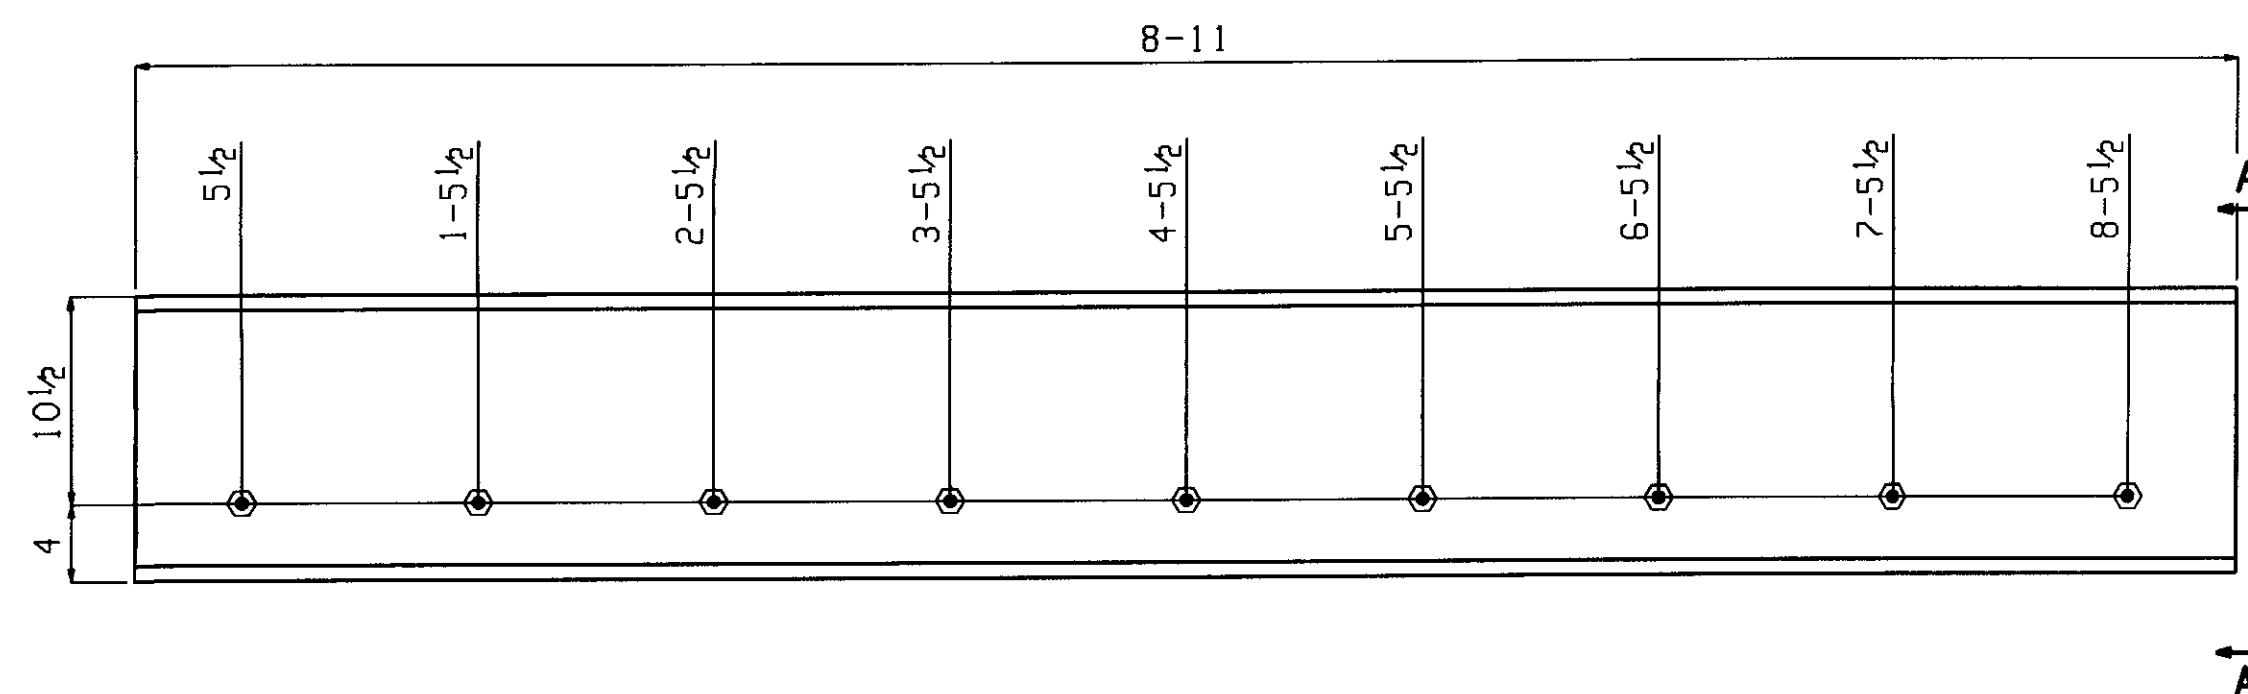

ONE MISC M2 GALV

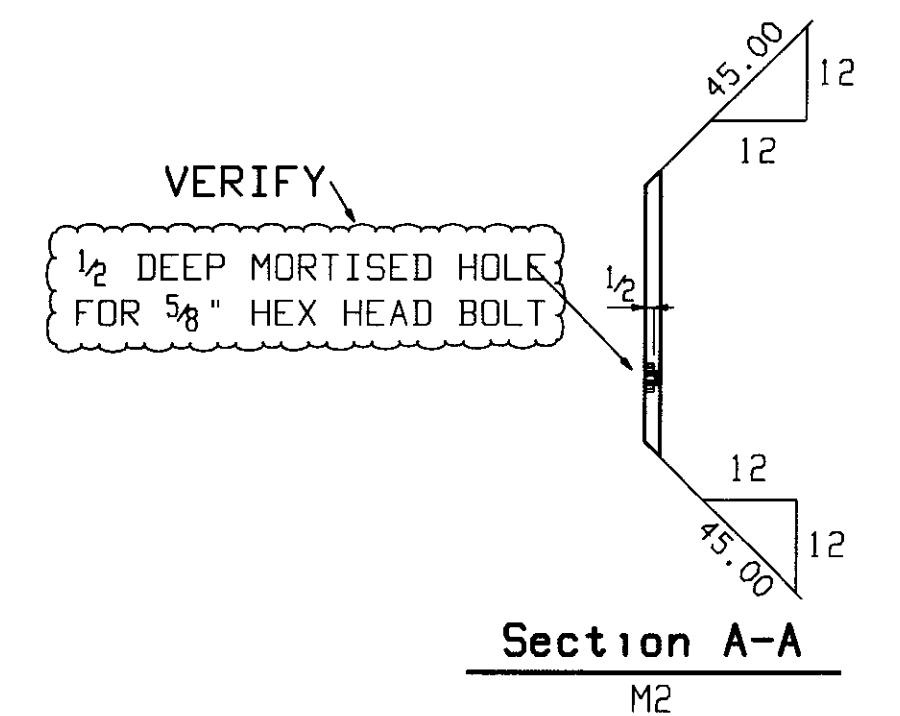

Section A-A M2

May 15 2008 03:03:51 PM

BILL OF MATERIAL									BILL OF MATERIAL									BILL OF MATERIAL								
Qty	Piece			Seq	Seq	Adv	Steel		Qty	Piece			Seq	Seq	Adv	Steel		Qty	Piece			Seq	Seq	Adv	Steel	
Tot.	Mark	Description	Length	NO.	Qty	ABM #	Grade	Remarks	Tot.	Mark	Description	Length	NO.	Qty	ABM #	Grade	Remarks	Tot.	Mark	Description	Length	NO.	Qty	ABM #	Grade	Remarks
8		HORIZONTAL BRACE		1	8				ONE		MISC		1	1			GALV									
8	HB1	L3x2 1/2 x 5/16	13	3 7/16			M270-50		1	M1	PL 3/4 x 14 1/2	8	11			M270-50										
4		HORIZONTAL BRACE		1	4				ONE		MISC		1	1			GALV									
4	HB2	L3x2 1/2 x 5/16	27	5 11/16			M270-50		1	M2	PL 3/4 x 14 1/2	8	11			M270-50										
															</											

Total weight 1832

RECEIVED
MAY 26 2009
APPROVED _____
DATE _____

Renaud Bros. Inc.
283 Fort Bridgeman Rd. #2
Vernon, VT. 05354
Phone 1-802 257-7383

Project: **WALLINGFORD BRIDGE**
WALLINGFORD, VT

Date: 4-28-09
Job No. _____
Checked: _____
Sheet No. HB1-2, M1-2