


May 15 2009 03:03:54 PM

BILL OF MATERIAL									BILL OF MATERIAL									BILL OF MATERIAL											
Qty	Piece				Seq	Seq	Adv	Steel		Qty	Piece				Seq	Seq	Adv	Steel		Qty	Piece				Seq	Seq	Adv	Steel	
Tot.	Mark	Description	Length		NO.	Qty	ABM #	Grade	Remarks	Tot.	Mark	Description	Length		NO.	Qty	ABM #	Grade	Remarks	Tot.	Mark	Description	Length		NO.	Qty	ABM #	Grade	Remarks
ONE		MISC			1	1																							
1	M3	L6x4x3/8	118	0 1/2				M270-50																					
ONE		MISC			1	1																							
1	M4	L6x4x3/8	118	0 1/2				M270-50																					


Total weight 2898

Renaud Bros. Inc. 283 Fort Bridgeman Rd. #2 Vernon, VT. 05354 Phone 1-802 257-7383		Rev.No:	Date:	Surface Prep:	PER SPECS
		Project:	Date:	Job No.	
		WALLINGFORD BRIDGE		DWN. BY:	Checked
		WALLINGFORD, VT		EG	Sheet No. M3, 4
		Holes:	1 3/8 UNF		
		BOLTS:	3/4" DIA M164-I GALV		
		Steel GR:	M270-50 UNF		
		Paint:	PER SPECS		

RECEIVED
CHKD BY _____
MAY 26 2009
RF SUBMIT _____
BY _____
APPROVED _____
DATE _____

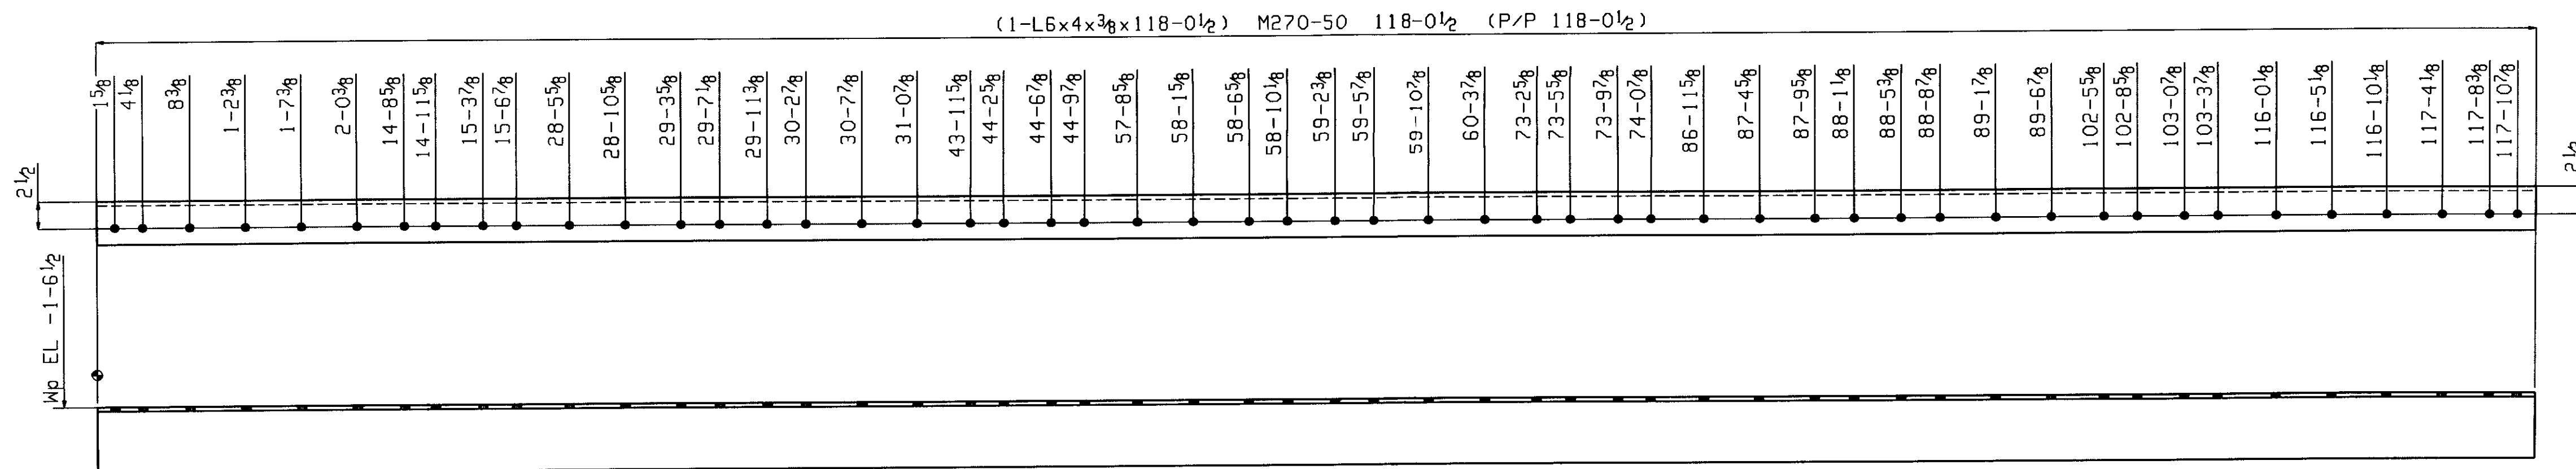

SHOP NOTE:
TOE DIRECTION NEAR SIDE

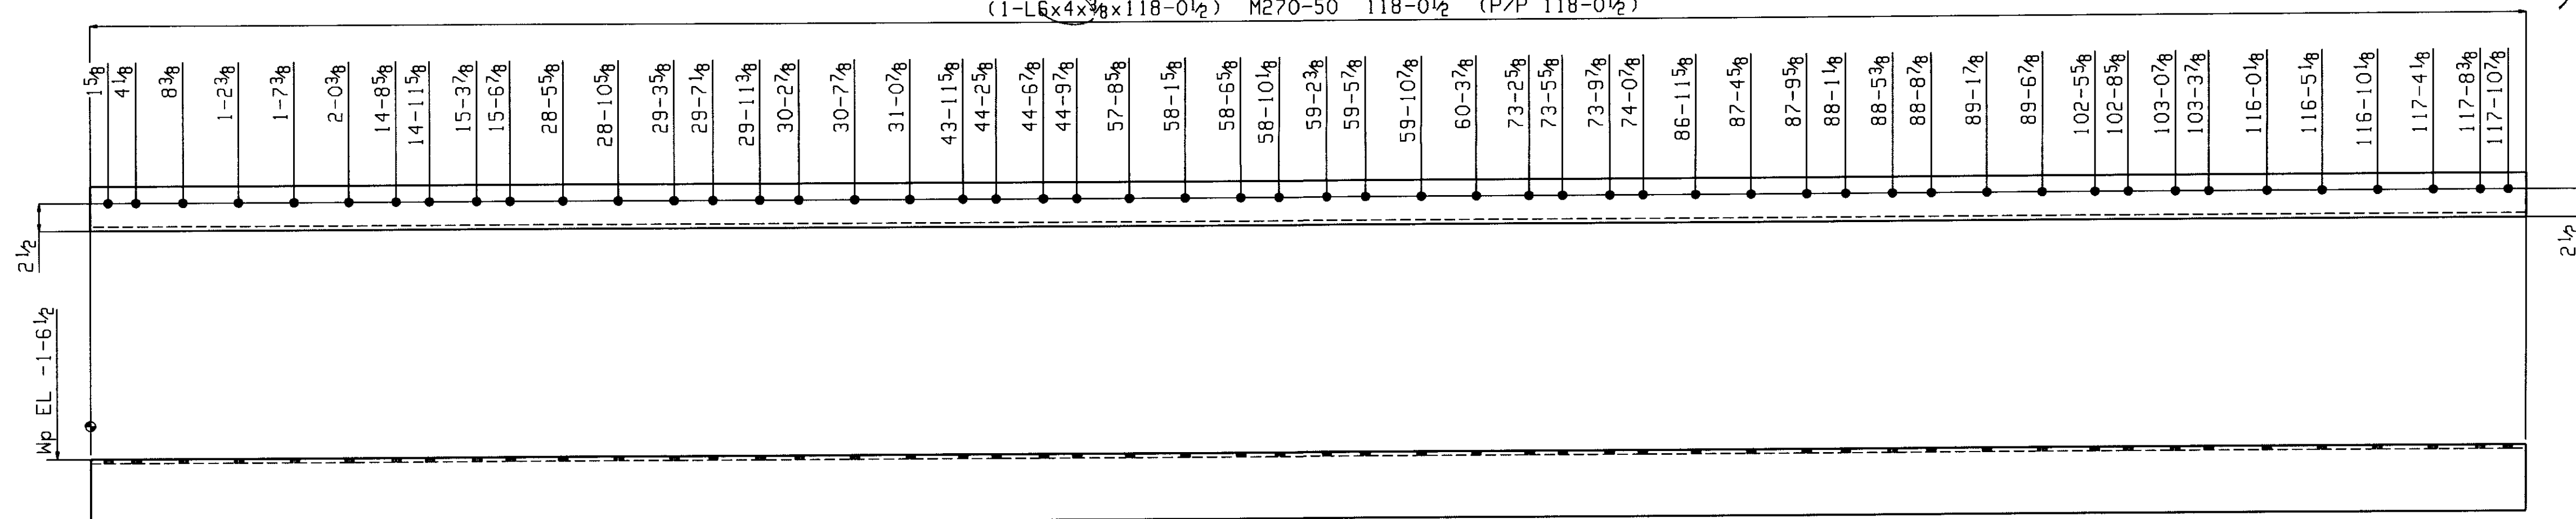

☐ NO EXCEPTION TAKEN
☐ REJECTED
☒ MAKE CORRECTIONS NOTED
☐ REVISE AND RESUBMIT
☐ SUBMIT SPECIFIED ITEM

CLIPPING IS ONLY FOR FINAL CONSTRUCTION. IT IS NOT TO BE USED FOR ANY OTHER PURPOSE. IT IS THE RESPONSIBILITY OF THE USER TO OBTAIN THE CORRECT INFORMATION FROM THE APPROPRIATE SOURCES. THE USER SHALL BE RESPONSIBLE FOR THE ACCURACY OF THE INFORMATION OBTAINED. THE USER SHALL BE RESPONSIBLE FOR THE ACCURACY OF THE INFORMATION OBTAINED. THE USER SHALL BE RESPONSIBLE FOR THE ACCURACY OF THE INFORMATION OBTAINED.

CLOUGH HARBOUR & ASSOCIATES LLP
ENGINEERS - ARCHITECTS - INTERIORS
& LANDSCAPE ARCHITECTS

DATE 6/1/09 BY [Signature]

SHOP NOTE:
TOE DIRECTION FAR SIDE

ONE MISC M4

ONE MISC M4

ONE MISC M4