
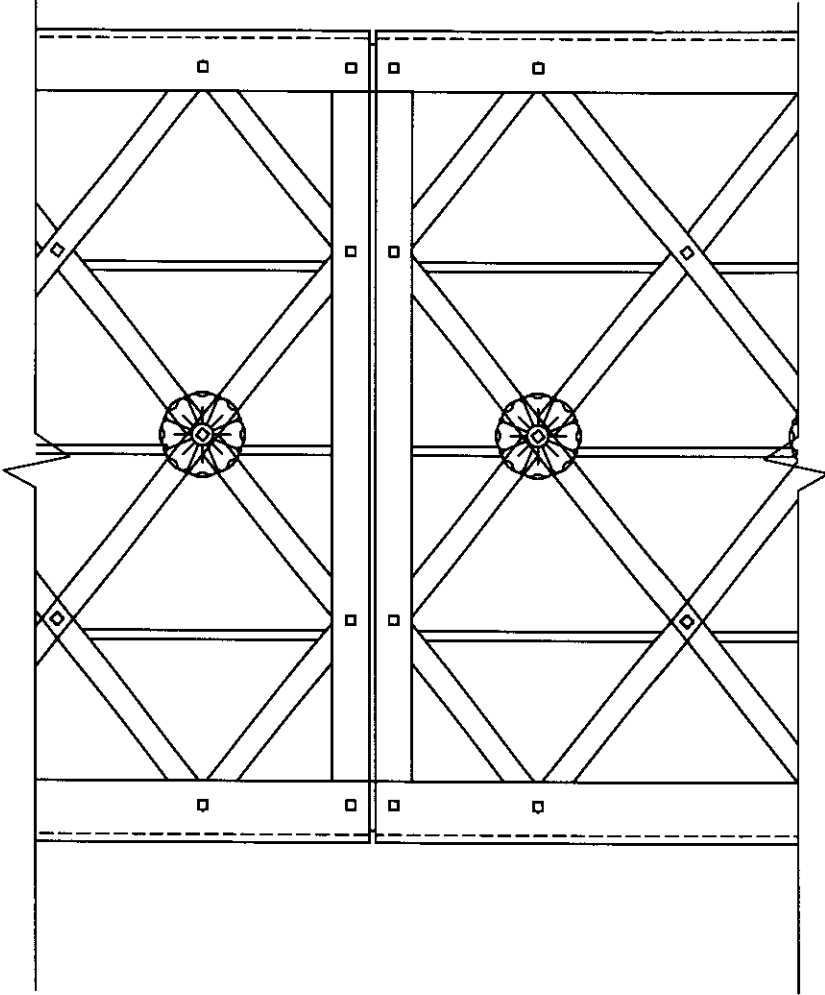
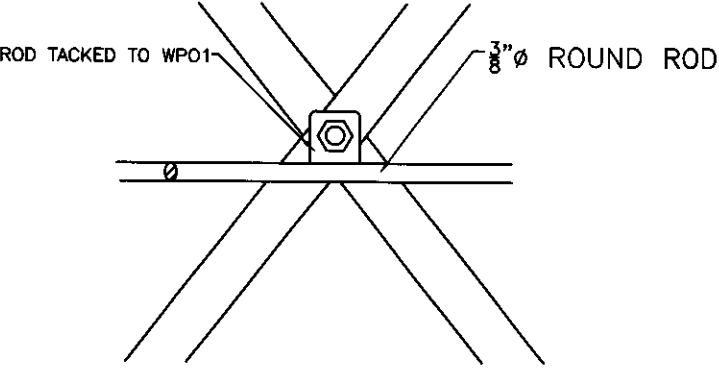
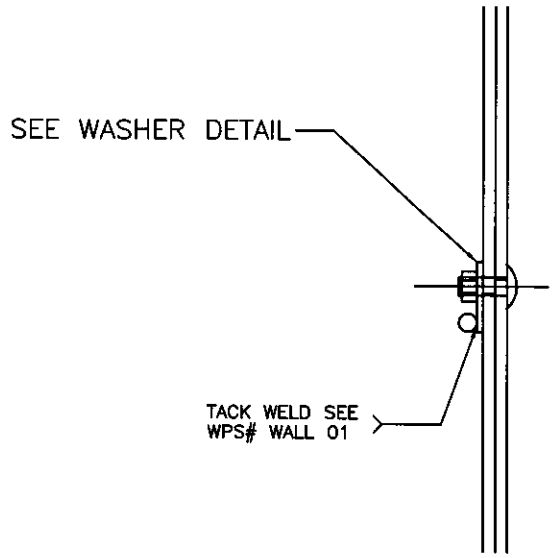
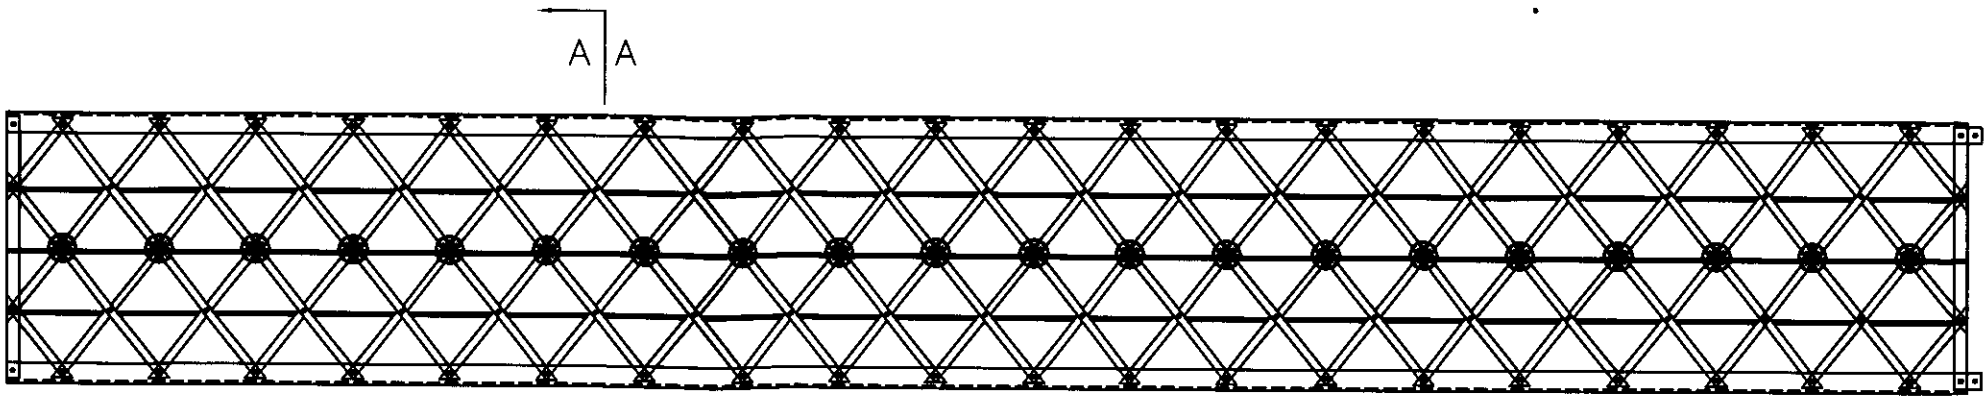
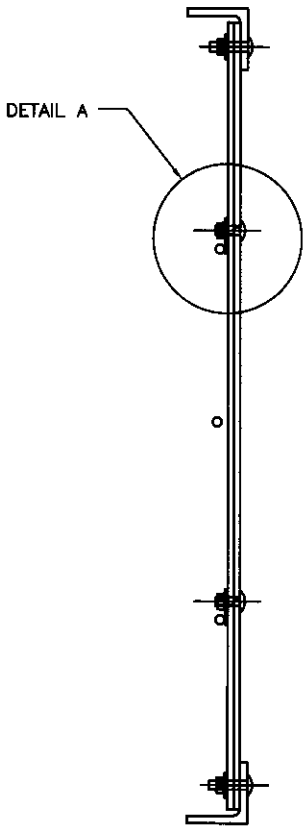


RAILNG SYSTEM:

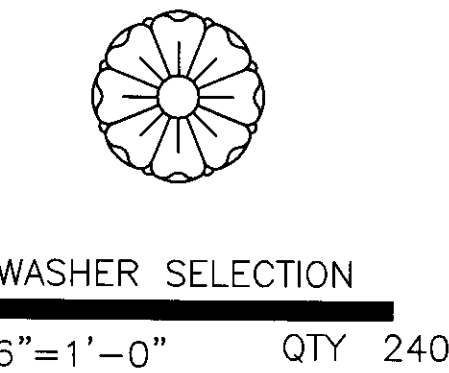

RECEIVED
DRAWN BY JED
CHECKED BY JED/AD
DATE 4/30/09

Renaud Bros Construction Renaud Bros Construction Renaud Bros Construction (802) 267-7383	
Wallingford Bridge Rehab Wallingford, VT	Drawings Railing System Drawings
DRAWN BY JED	JOB CONTACT Erick Foster State of VT
CHECKED BY JED/AD	DATE 4/30/09
DRAWING NO.	R-1
SHEET NO.	2 of 10