



RAILING SYSTEM:

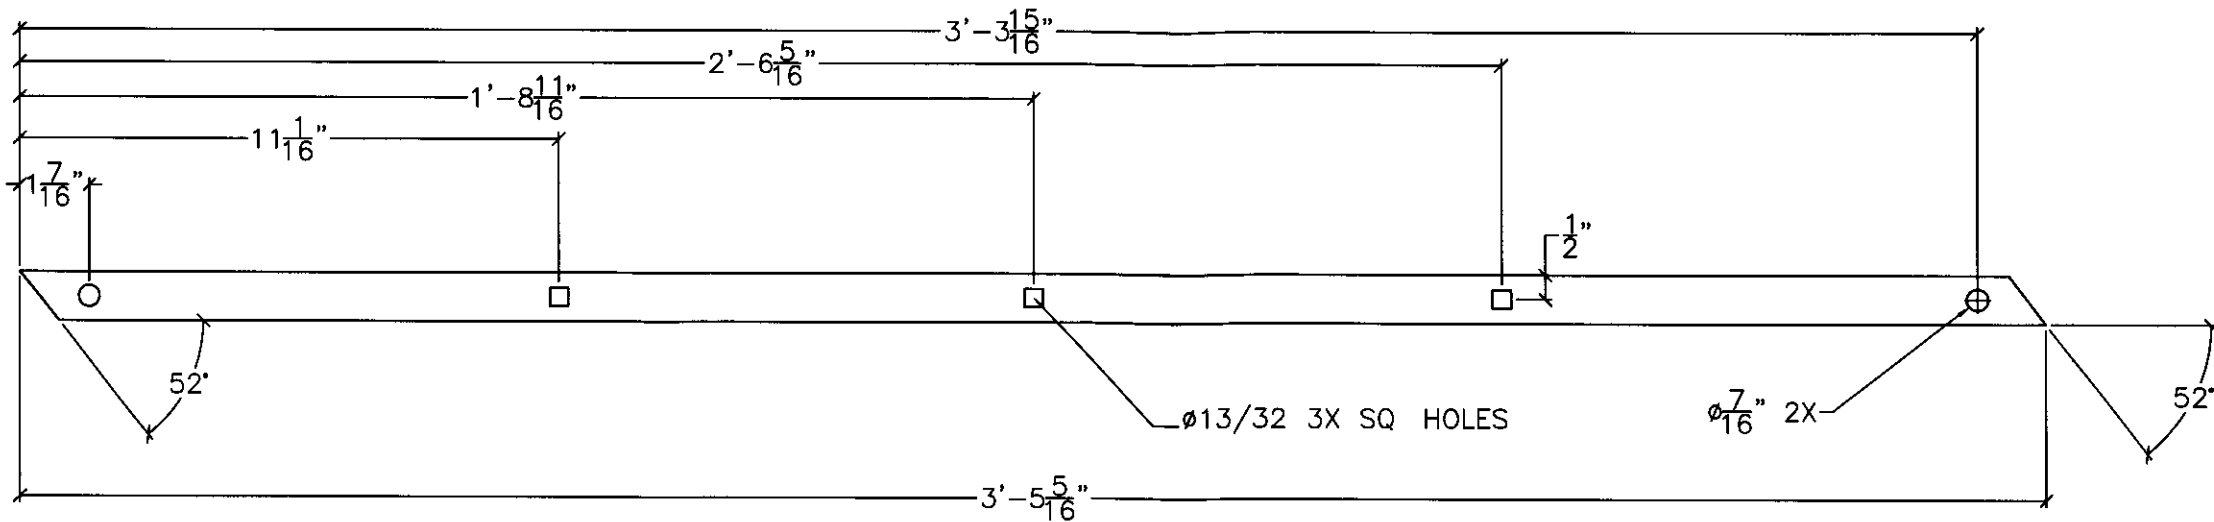

HR01: PLATE-1/4"

6" = 1'-0" QTY. 216

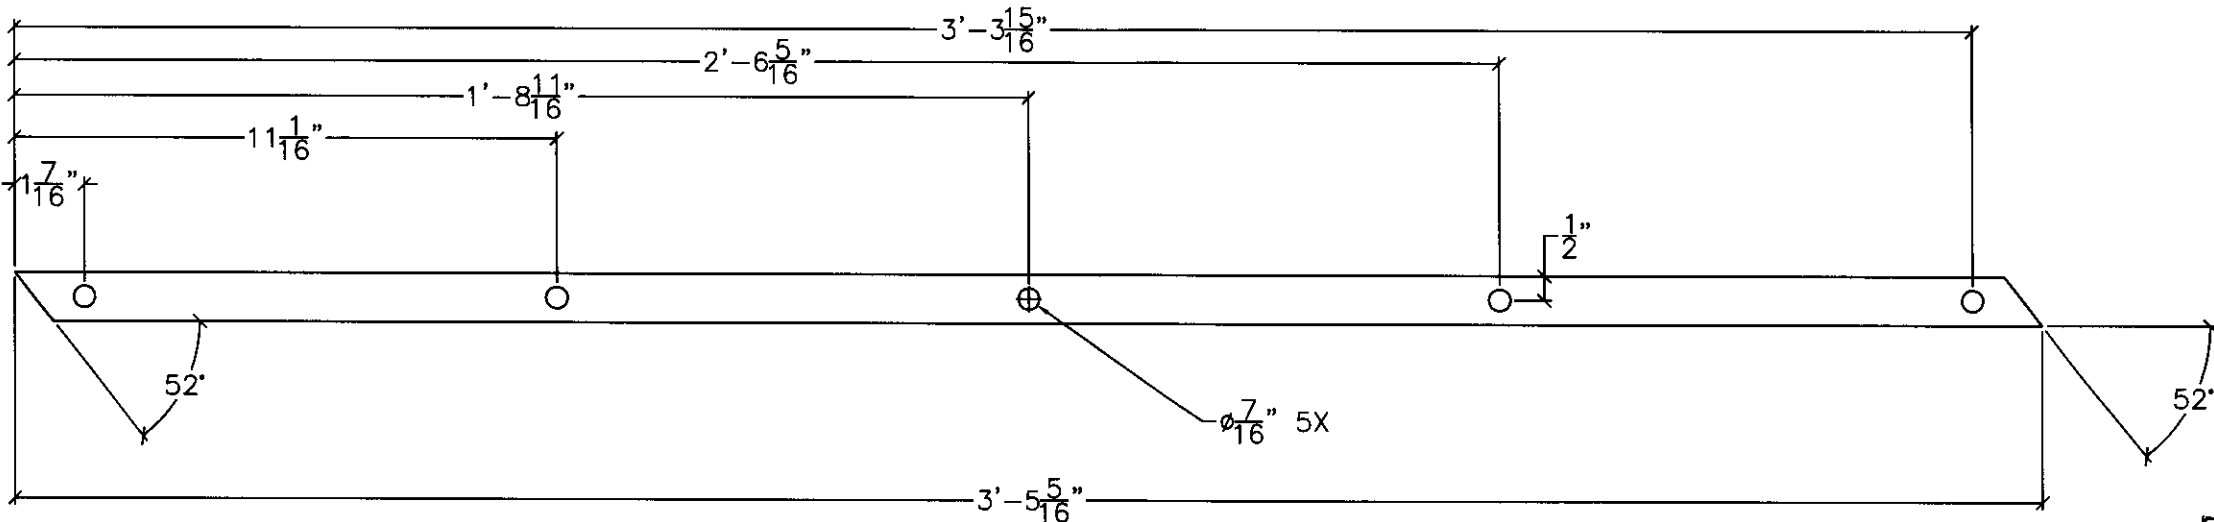

HR02: PLATE-1/4"

6" = 1'-0" QTY. 216

RECEIVED
CK'D BY _____ OK'D BY _____
JUL 31 2017
BY *W.A. 9/* APPROVED *✓*
DATE *8/1/17*

Renaud Bros Construction Renaud Bros Construction (802) 257-7383	
Wallingford Bridge Rehab	
Wallingford, VT	
DRAWING TITLE	
Drawings Railing System Drawings	
DRAWN BY JED	JOB CONTACT Erick Foster State of VT
CHECKED BY JED/AD	DATE 4 30 09
DRAWING NO.	
R-1	
SHEET NO.	
3 OF 10	