




RAILNG SYSTEM:

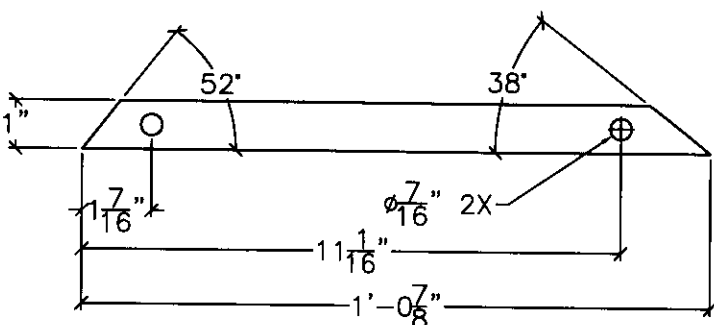


HR05: PLATE-1/4"
6" = 1'-0" QTY. 48

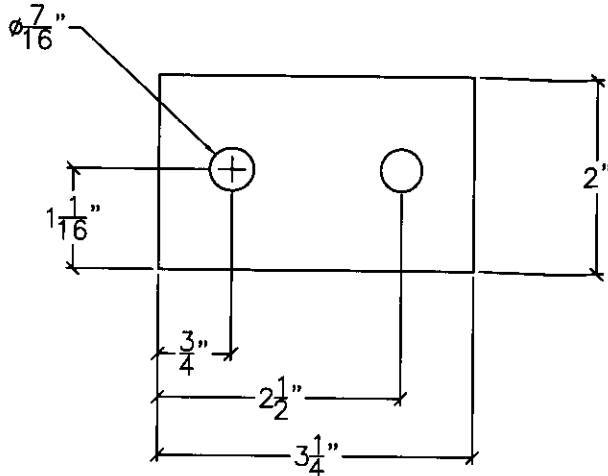

HR08: PLATE-1/4"
1'-0" = 1'-0" QTY. 12

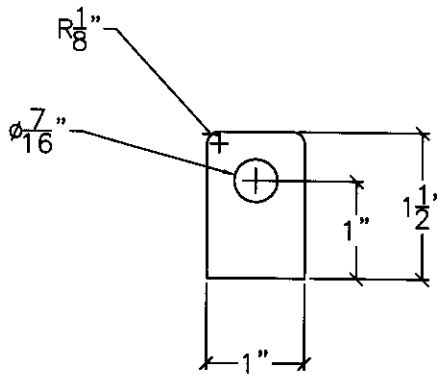

W01: PLATE-1/4"
1'-0" = 1'-0" QTY. 775

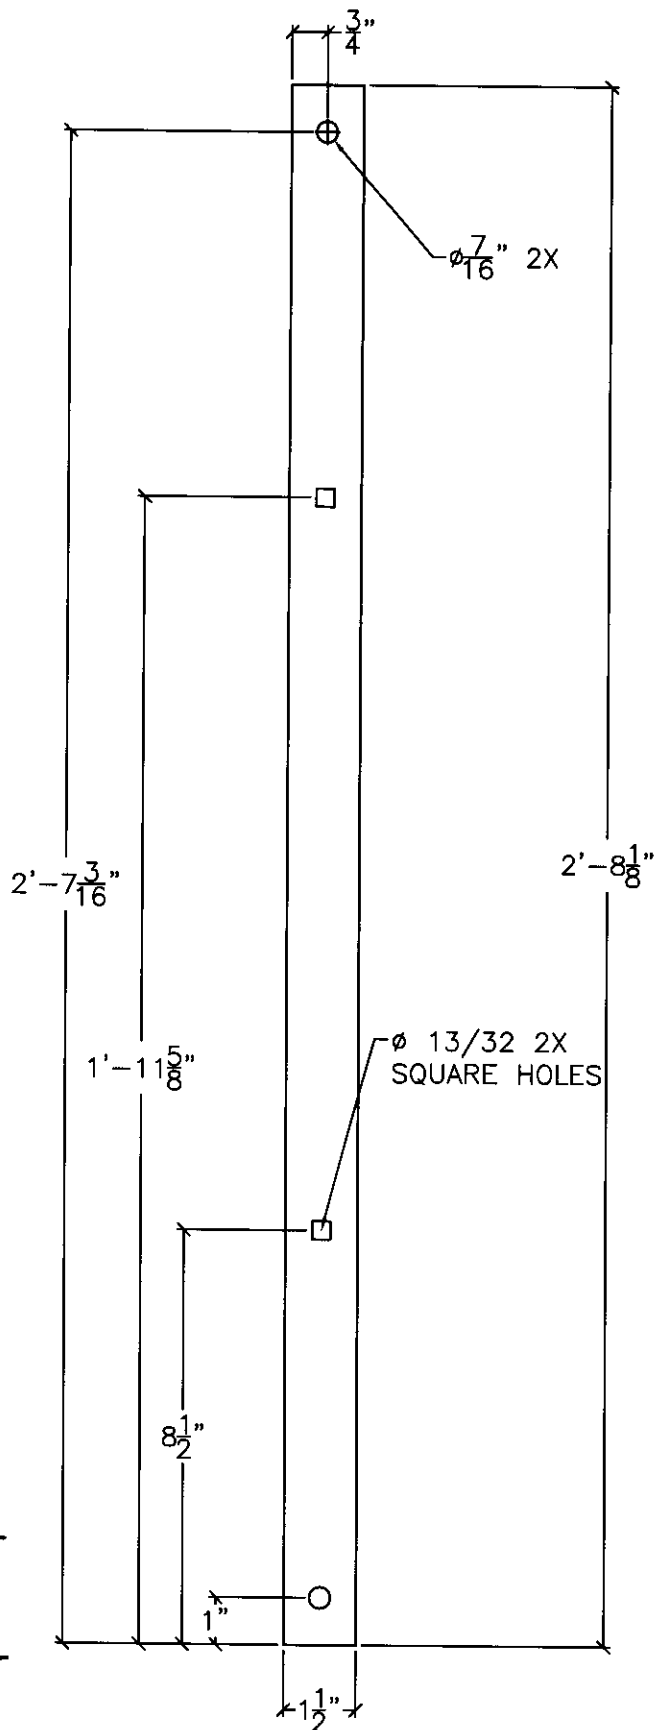

RECEIVED
OK'D BY _____
JUL 31 2008
BY *W.P.S.* DATE *8/6/08*

HR09: PLATE-1/4"
6" = 1'-0" QTY. 24

Rising Star Construction P.O. Box 1000 Falmouth, ME 04101 (207) 257-7383	
TITLE	Wallingford Bridge Rehab
LOCATION	Wallingford, VT
DRAWING NO.	Drawings Railing System Drawings
DRAWN BY	JED
CHECKED BY	JED/AD
DATE	4-30-08
JOB CONTACT	Erick Foster State of VT
R-1	
5 of 10	