



RAILING SYSTEM:

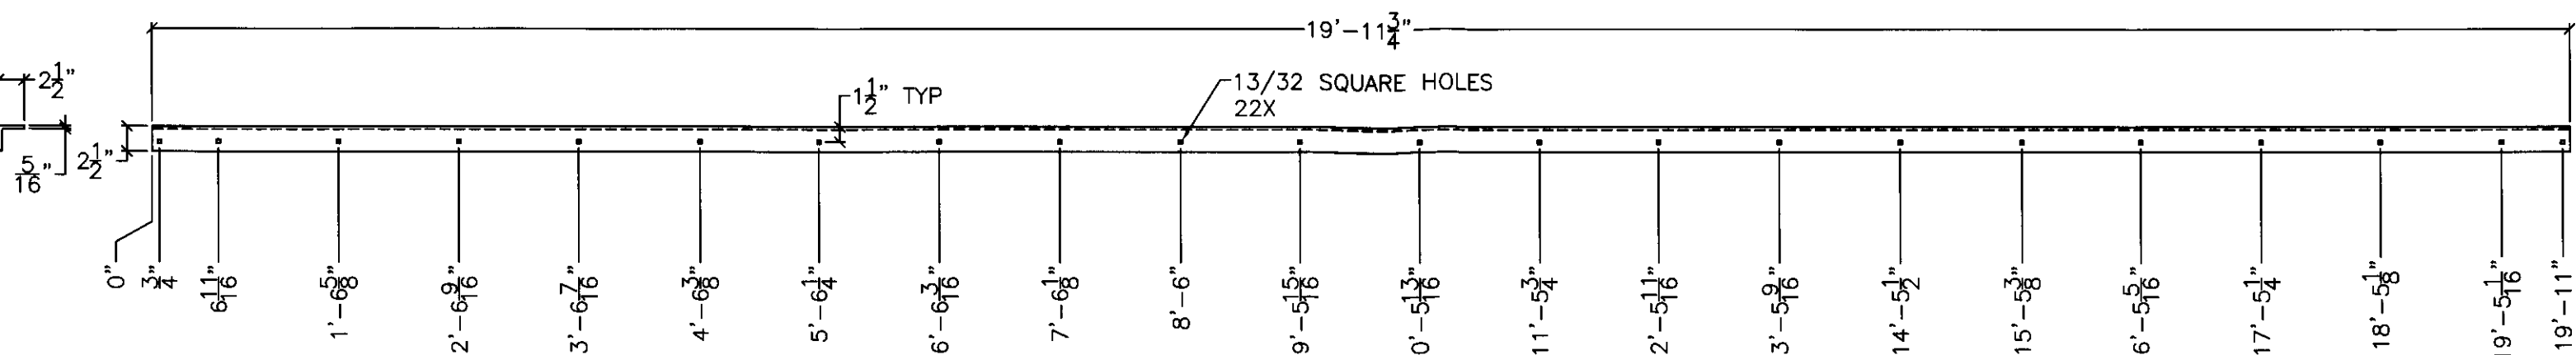

HR06, HR07: -ANGLE
1-1/2" = 1'-0" QTY. 24

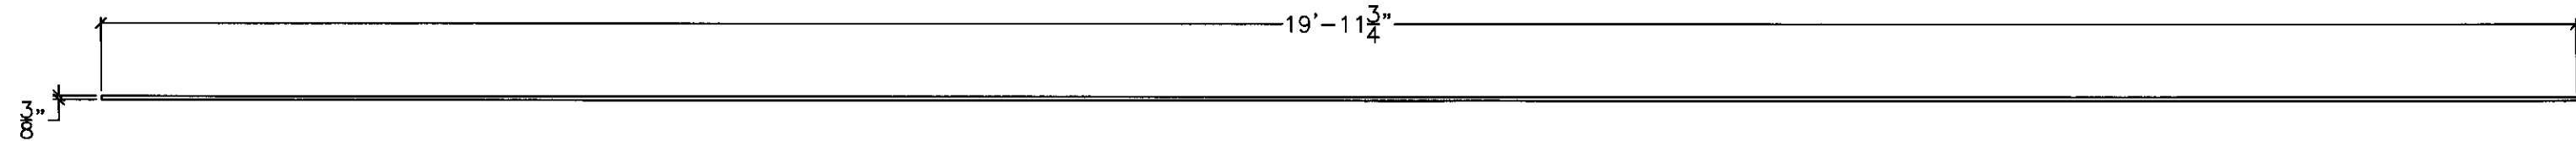

HR10: -3/8 ROUND STOCK
1-1/2" = 1'-0" QTY. 36

RECEIVED
JUL 31 2009
BY: WYB.SJ DATE: 8/6/09

Title Wallingford Bridge Rehab Location Wallingford, VT		Revised Date Construction For Paper Release V10094 (802) 257-7383	
Drawing Title Drawings Railing System Drawings		Drawn By JED Job Contact Erick Foster State of VT	
Checked By JED/AD Date 4 30 09		SHEET NO 6 OF 10	
R-1			