




RAILNG SYSTEM: FLARED END LEFT

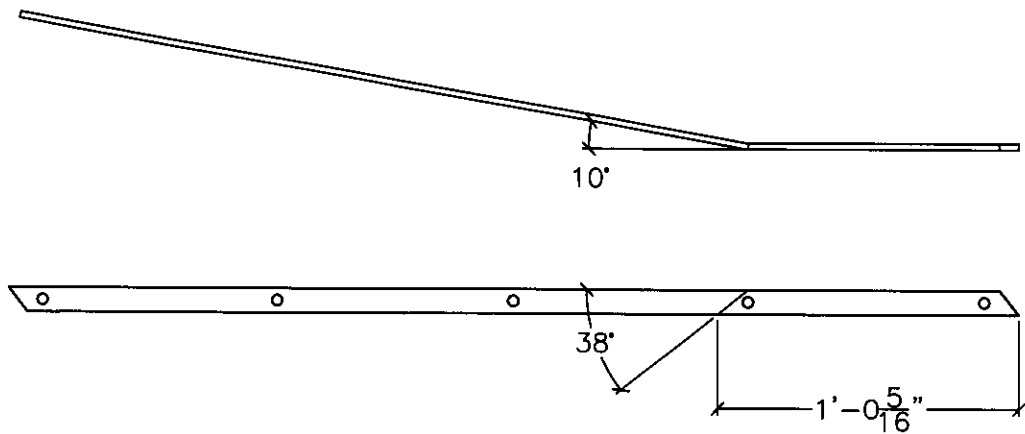


HRO21: LATTICE (USE HRO2)
3" = 1'-0" QTY 2

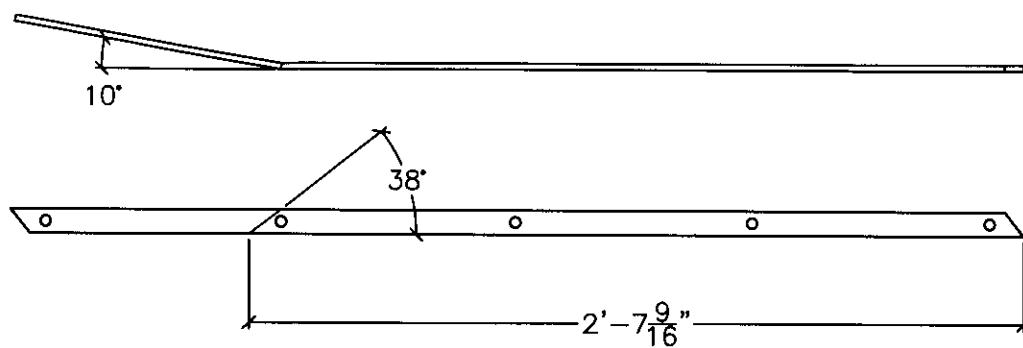

HRO22; LATTICE (USE HRO2)
3" = 1'-0" QTY 2

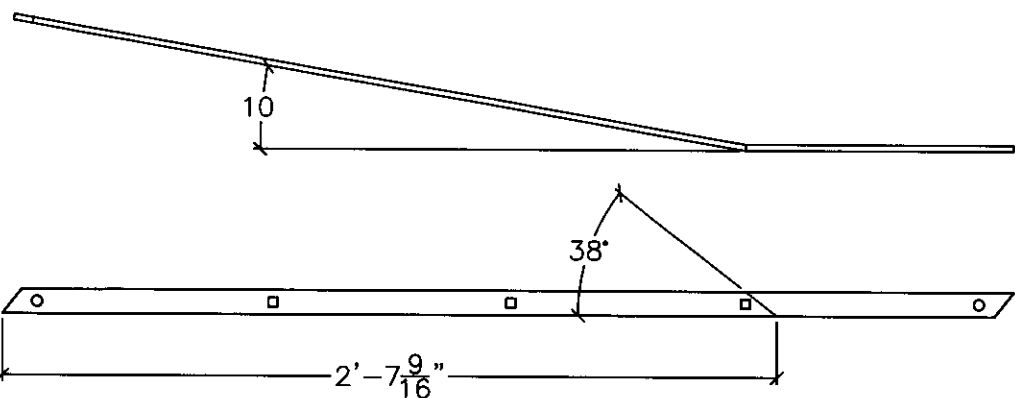

HRO11: -LATTICE(USE HRO1)
3" = 1'-0" QTY 2

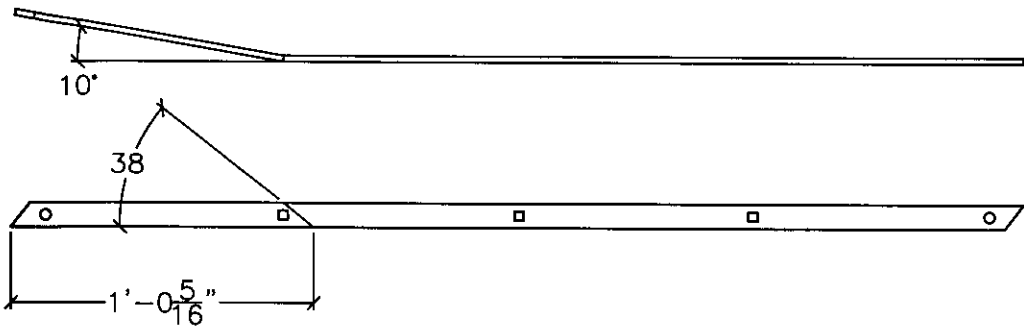

HRO12 -LATTICE (USE HRO1)
3" = 1'-0" QTY 2

RECEIVED
JUL 31 2009
BY *WFS* DATE *8/1/09*

Renard Bros. Construction Renard Bros. Construction (802) 257-7383	
TITLE: Wallingford Bridge Rehab LOCATION: Wallingford, VT	
DRAWING TITLE: Drawings Railing System Drawings	DRAWN BY: JED
CHECKED BY: JED/AD	DATE: 4 30 09
DRAWING NO. R-1	
SHEET NO. 7 OF 10	