

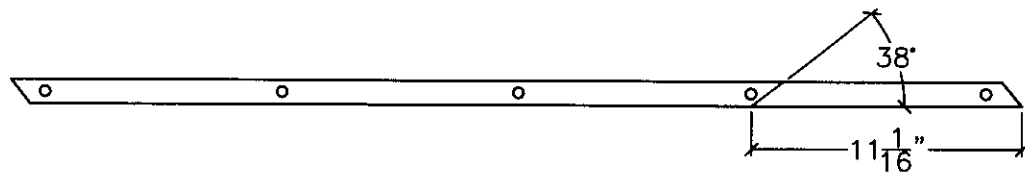
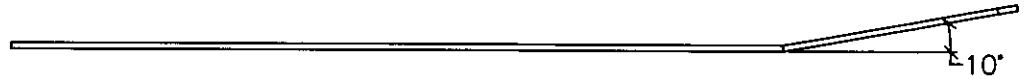


RAILING SYSTEM: FLARED END RIGHT

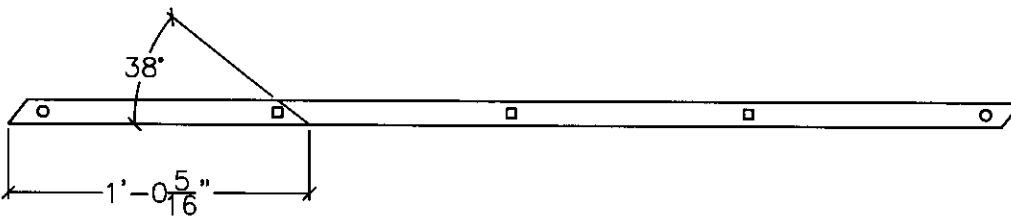



HRO23; LATTICE (USE HRO2)

3" = 1'-0" QTY 2

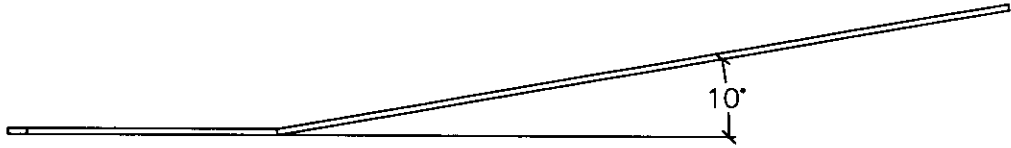



HRO13; LATTICE (USE HRO1)

3" = 1'-0" QTY 2

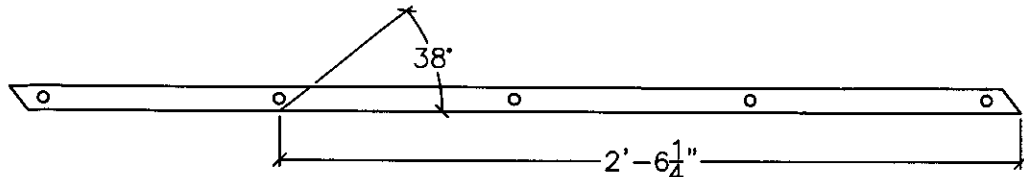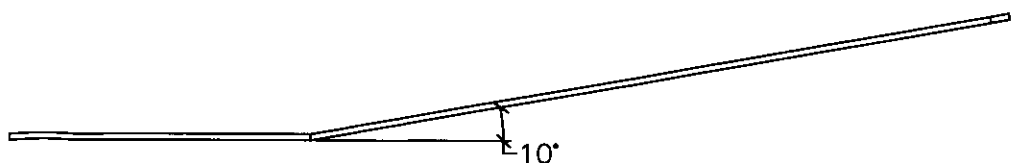

HRO24; LATTICE (USE HRO2)

3" = 1'-0" QTY 2

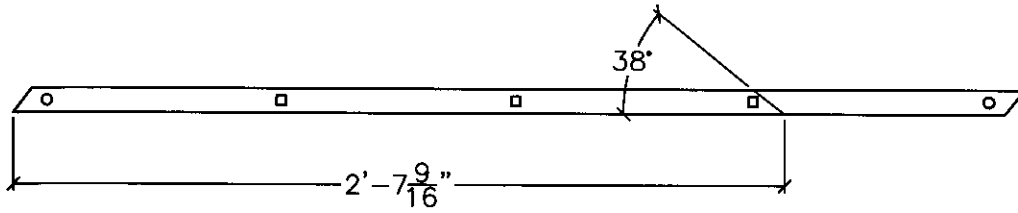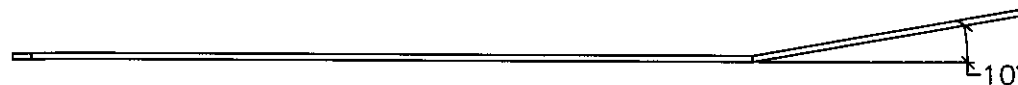

HRO14; LATTICE (USE HRO1)

3" = 1'-0" QTY 2

RECEIVED

OK'D BY _____ OK'D BY _____

JUL 31 2009

BY _____ DATE 8/6/09

Renard Bros. Construction Renard Bros. Construction Renard Bros. Construction (802) 257-7353	
TITLE: Wallingford Bridge Rehab LOCATION: Wallingford, VT	
DRAWING TITLE: Drawings Railing System	DRAWINGS: Drawings
DRAWN BY: JED	JOB CONTACT: Eric Foster State of VT
CHECKED BY: JED/AD	DATE: 4/30/09
DRAWING NO: R-1	
SHEET NO: 8 OF 10	