



RAILING SYSTEM:

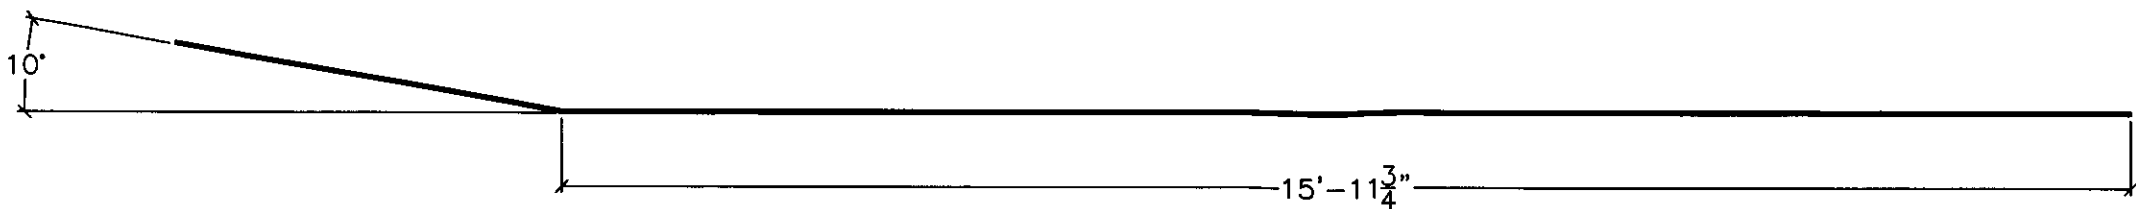

HR101; 3/8 ROUND STOCK (USE HR10)

1" = 1'-0" QTY 12

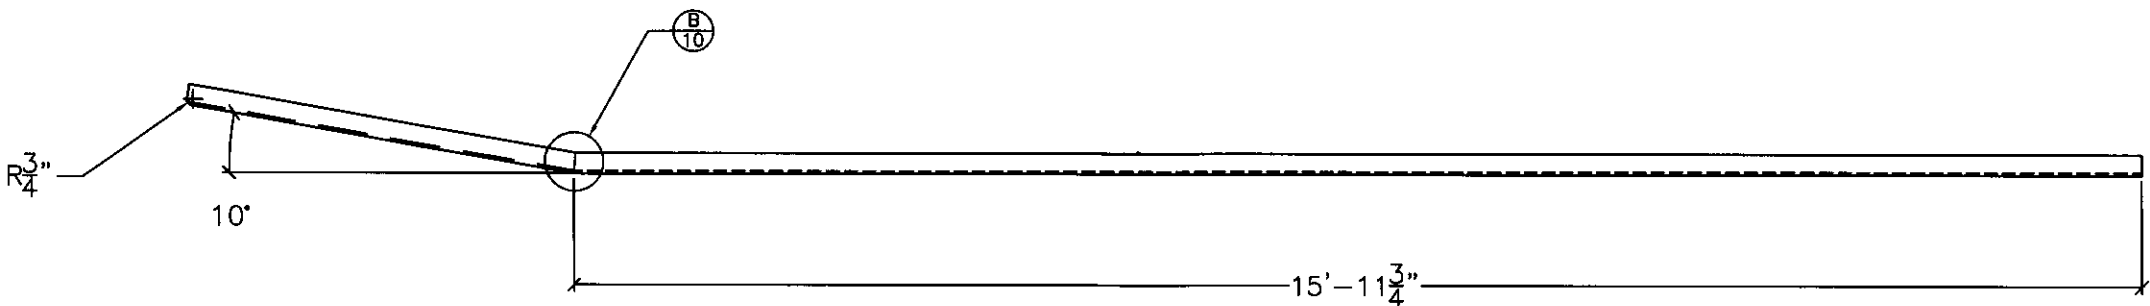

HR081,HR091; ANGLE (USE HR06)

1" = 1'-0" QTY 4

RECEIVED
OK'D BY _____ OK'D BY _____
JUL 31 2009
BY *W.P. St* DATE *8/4/09*

Renaud Bros Construction Renaud Bros Construction (802) 257-7383	
Wallingford Bridge Rehab	
Wallingford, VT	
DRAWING TITLE	DRAWINGS RAILING SYSTEM DRAWINGS
DRAWN BY JED	JOB CONTACT Erick Foster State of VT
CHECKED BY JED/AD	DATE 4-30-09
DRAWING NO	R-1
SHEET NO	9 OF 10