



RAILING SYSTEM:

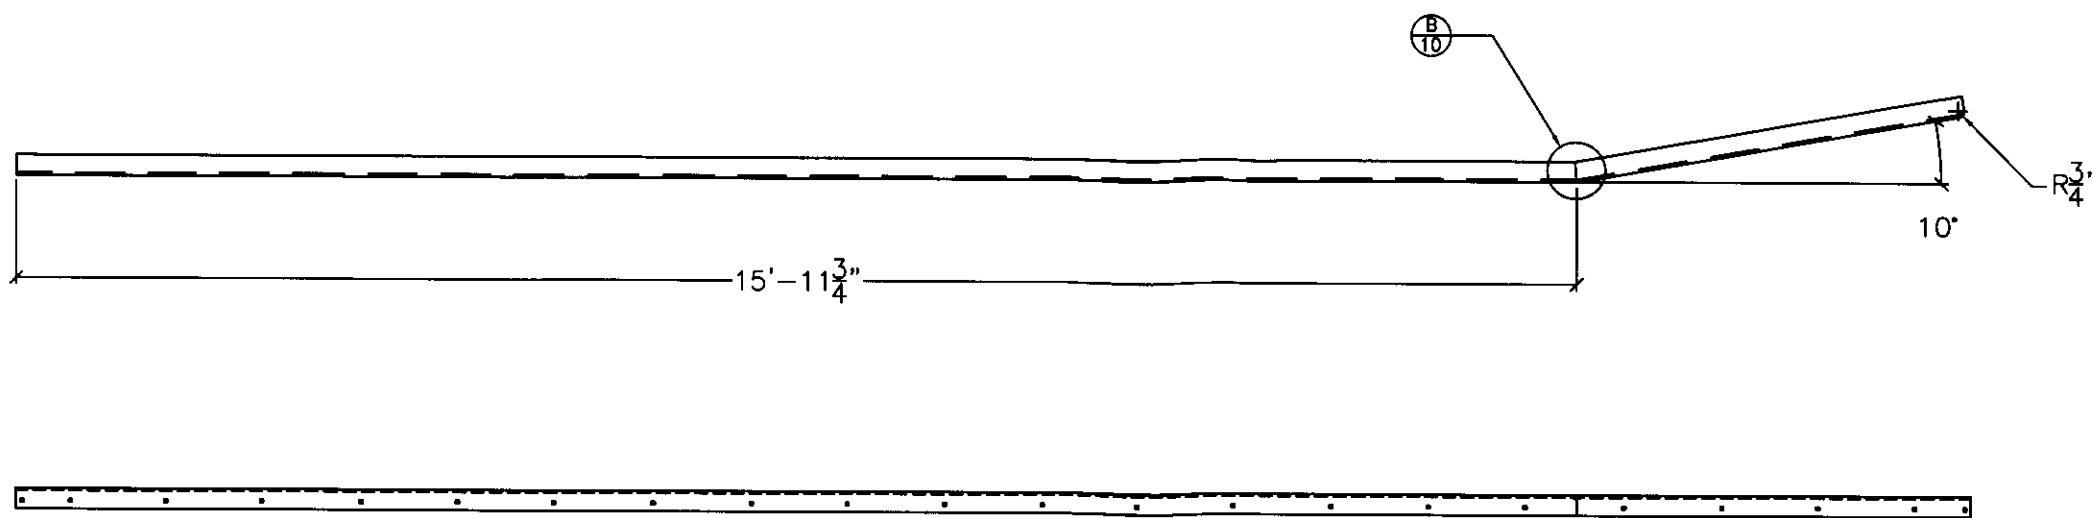


HR082, HR092: -ANGLE (USE HR07)
1" = 1'-0" QTY 4

- NOTES
- *RELIEF CUT TO BE MADE IN ANGLE, THEN BENT AND WELDED
 - *BENDS TO BE PERFORMED COLD, ON A PRESS BRAKE

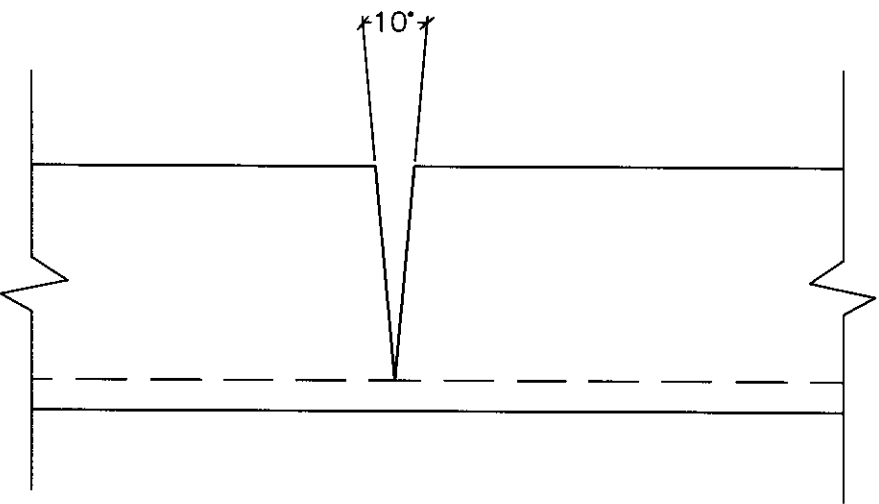

RELIEF CUT DETAIL
1'-0"=1'-0"

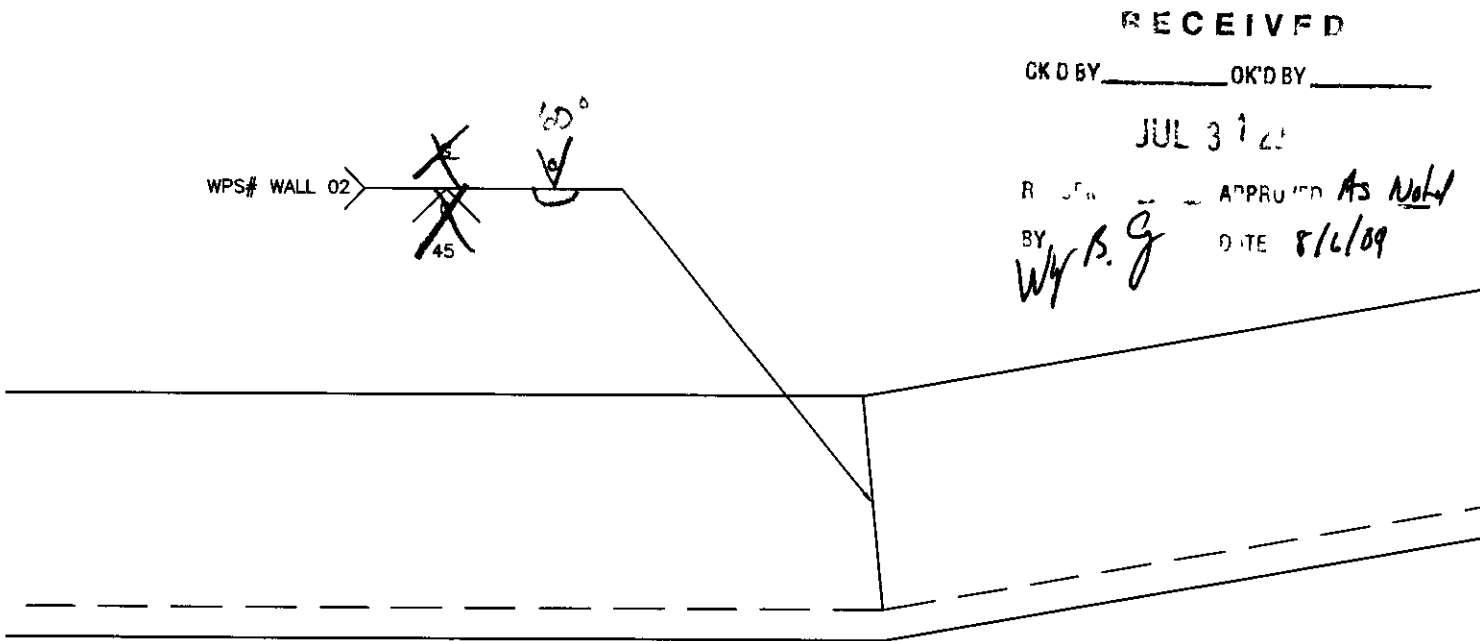

B
10 WELD DETAIL AT FLARE
1"=1'

Renard Bros. Construction Renard Bros. Construction (802) 257-7383	
TITLE: Wallingford Bridge Rehab LOCATION: Wallingford, VT	
DRAWING TITLE: Drawings Railing System	
DRAWN BY: JED	DATE: 8/2/09
CHECKED BY: JED/AD	DATE: 4/30/09
JOB CONTACT: Erik Foster State of VT	
DRAWING NO. R-1	
SHEET NO. 10 OF 10	