
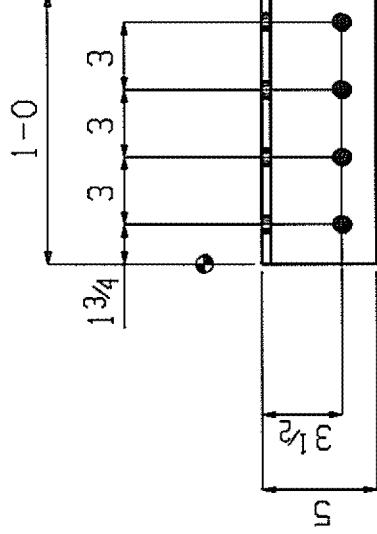


- NO EXCEPTION TAKEN
- MAKE CORRECTIONS NOTED
- REVISI AND RESUBMIT
- SUBMIT SPECIFIED

CHECKS IS ONLY FOR GENERAL CONFORMANCE WITH THE DESIGN CONCEPT OF THE PROJECT AND GENERAL COMPLIANCE WITH THE INFORMATION GIVEN IN THE CONTRACT DOCUMENTS. ANY AGING SIGNS IS SUBJECT TO THE REQUIREMENTS OF THE PLANS AND SPECIFICATIONS. CONTRACTOR IS RESPONSIBLE FOR INSPECTIONS WHICH WILL BE CONFERRED AND CORRELATED TO THE JOB SITE SUPERVISION. PROGRESS AND TECHNIQUES OF CONSTRUCTION COORDINATION OF HIS WORK WITH THAT OF ALL OTHER TRADES AND THE SATISFACTORY COMPLETION OF HIS WORK.

CLUBBINS-BROOKER & ASSOCIATES
 133 1/2
 13/4

6/3/09

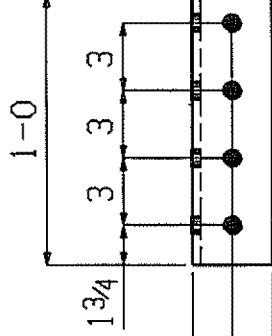

18 L5x3 1/2 x 3/8 x 1-0 a1

GRADE: M270-50

RECEIVED

CK'D BY _____ OK'D BY _____

MAY 26 2009

RESUBMIT _____ APPROVED _____

BY _____ DATE _____

Renaud Bros. Inc.
 283 Fort Bridgeman Rd. #2
 Vernon, VT. 05354
 Phone 1-802 257-7383

JOB: **WALLINGFORD BRIDGE**
 WALLINGFORD, VT

PART	
STL GR: M270-50 UNQ	DRWN BY: EG
HOLES: 1 3/16 UNQ	CHK: _____
DATE: 5-11-09	SHT: a1
JOB NO:	

BOLTS: 3/4" DIA. M164-I GALV