


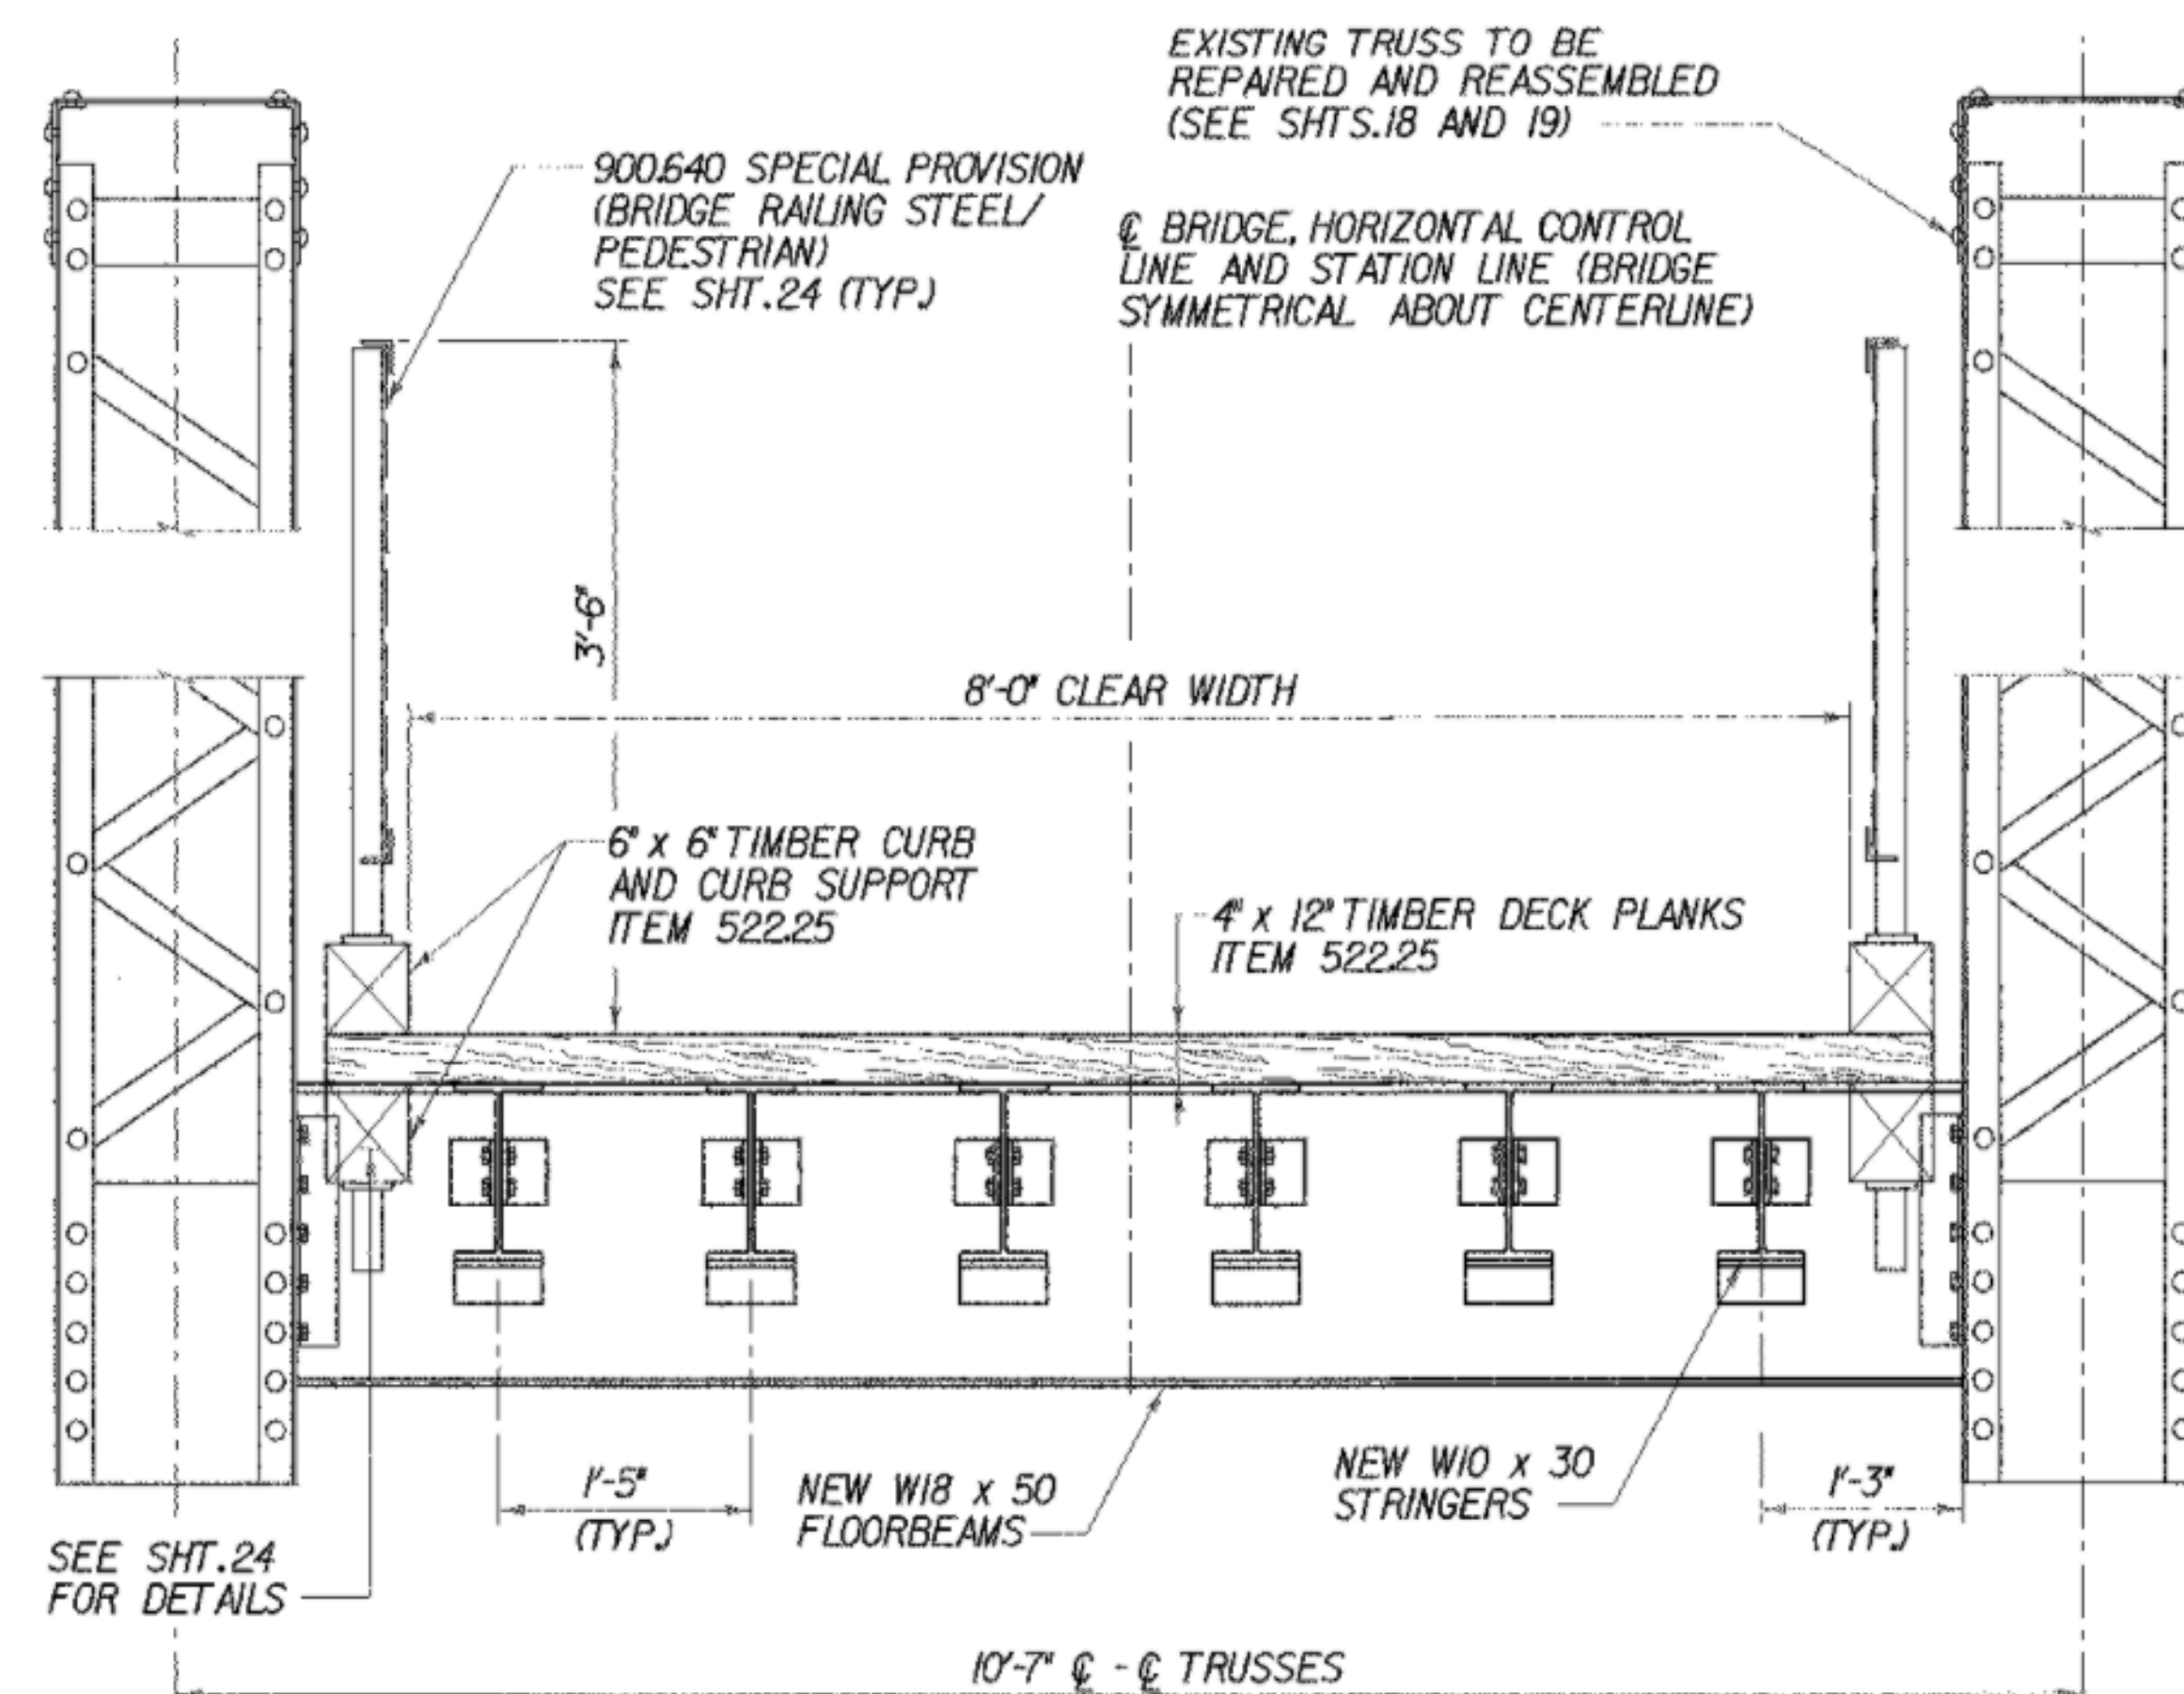


TYPICAL BRIDGE SECTION

SCALE 1" = 1'-0"

**NOTE:**

SEE STRUCTURAL STEEL AND TRUSS REHABILITATION NOTES ON SHT.13 FOR PAYMENT INFORMATION ON STRUCTURAL STEEL, SURFACE PREPARATION AND PAINTING ITEMS.

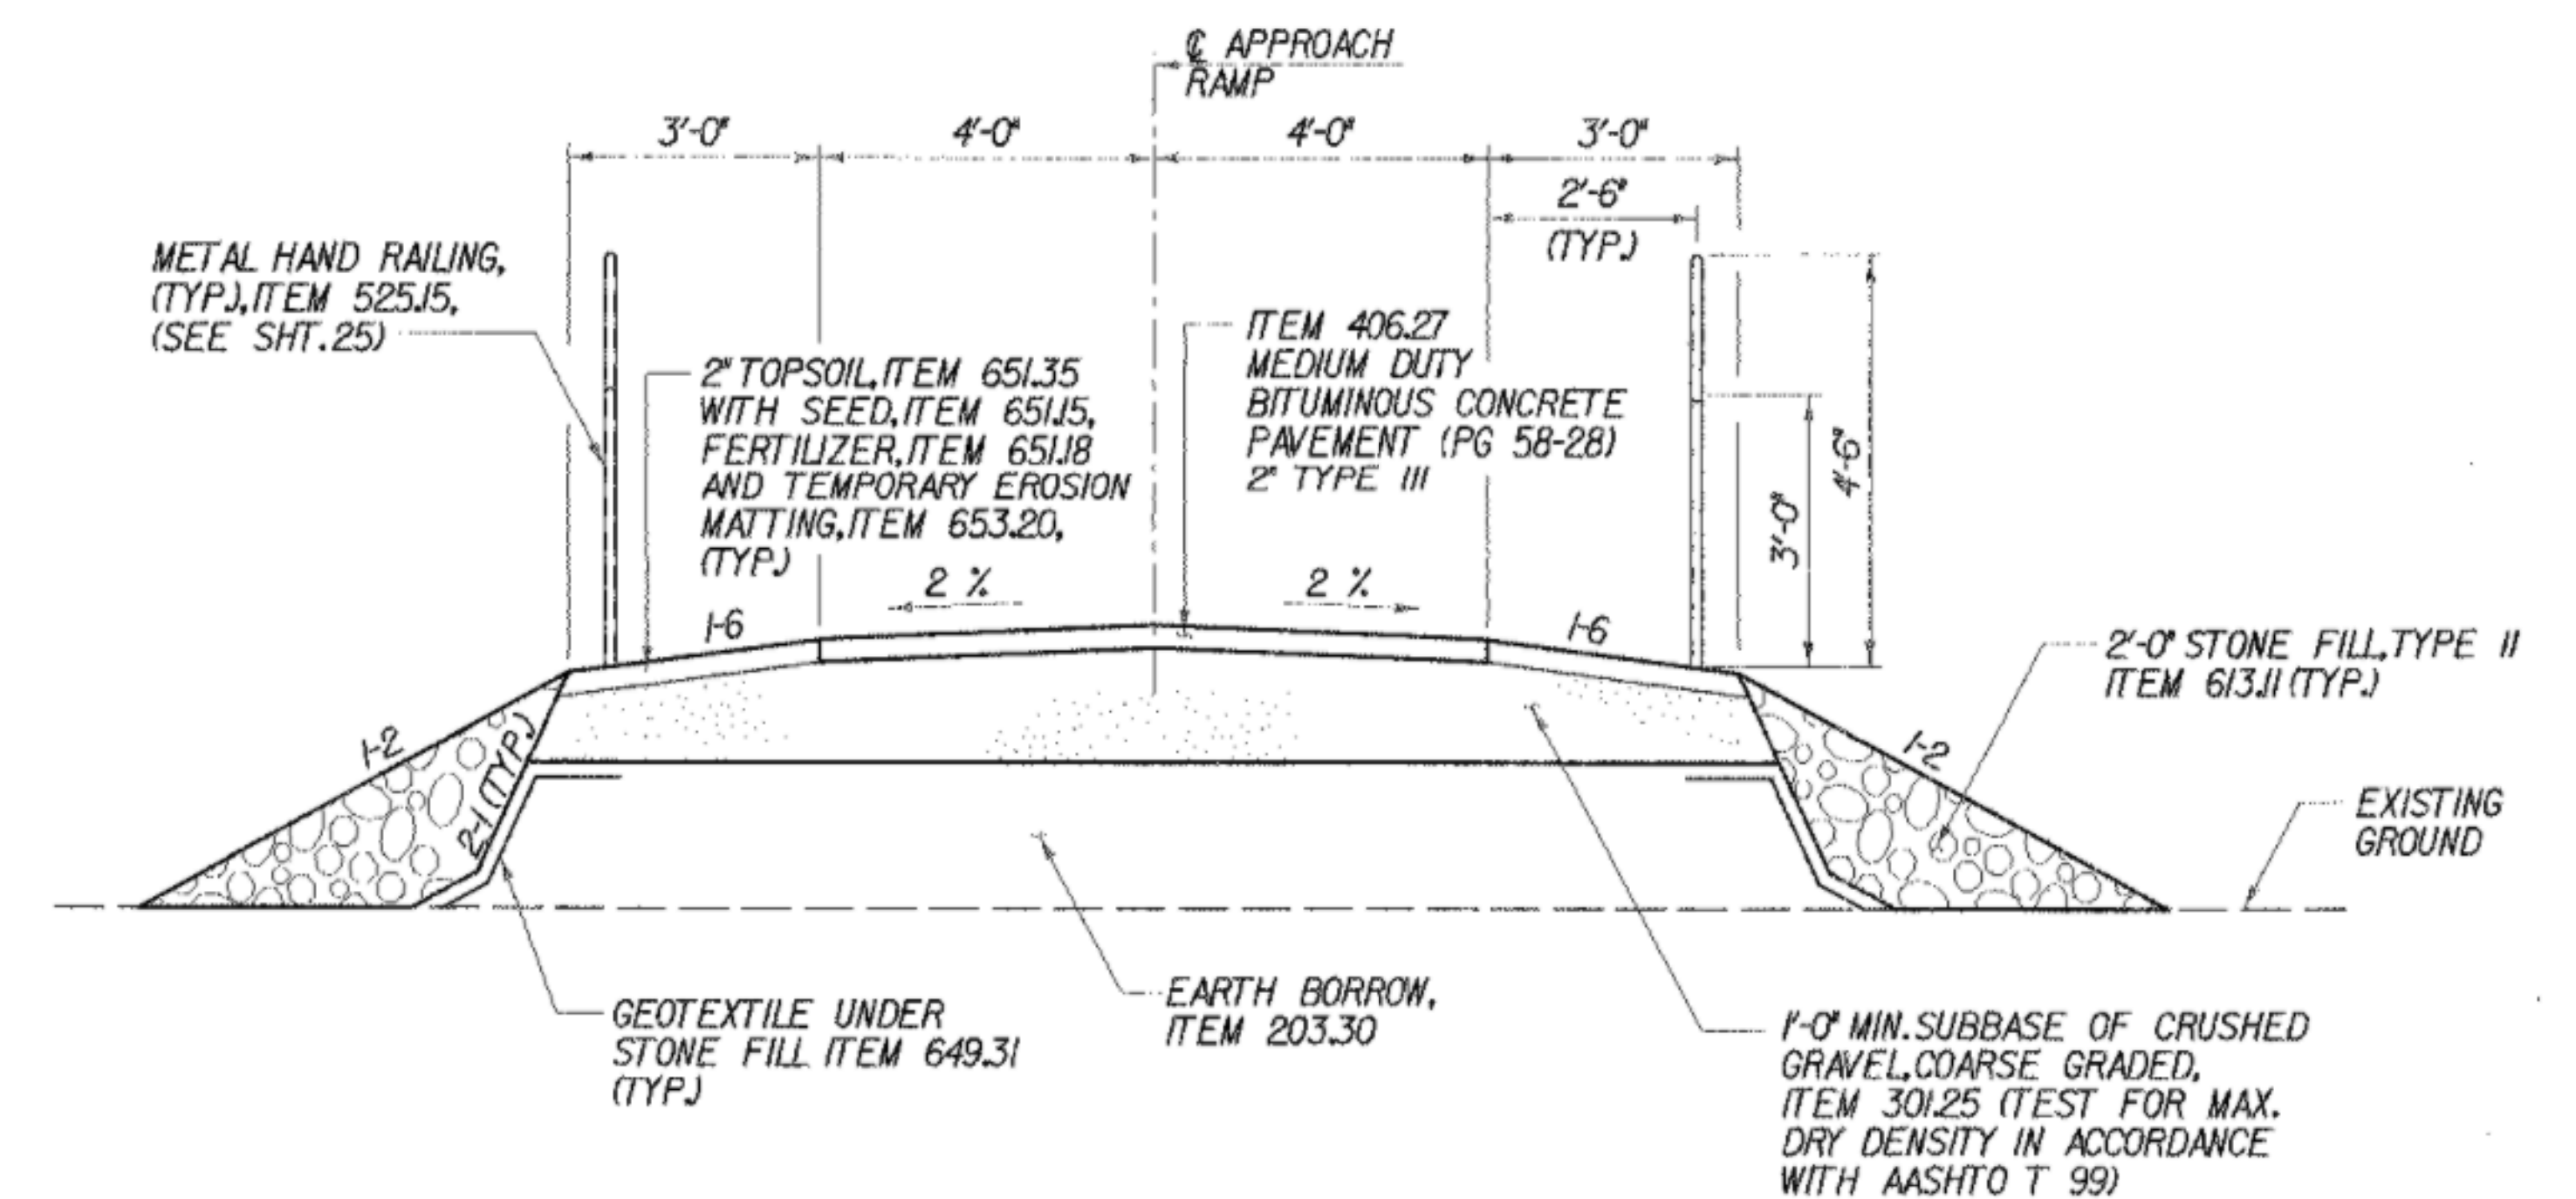

TYPICAL APPROACH RAMP SECTION

SCALE 1/2" = 1'-0"

**SEEDING FORMULA  
RURAL AREAS**

| % WT. | LBS./A. | NAME                | PUR % | GERM % |
|-------|---------|---------------------|-------|--------|
| 37.5  | 22.5    | CREEPING RED FESCUE | 98    | 85     |
| 37.5  | 22.5    | TALL FESCUE         | 95    | 90     |
| 5.0   | 3.0     | RED TOP             | 95    | 90     |
| 15.0  | 9.0     | BIRDSFOOT TREFOIL   | 98    | 85     |
| 5.0   | 3.0     | ANNUAL RYEGRASS     | 95    | 85     |
| 100.0 | 60.0    |                     |       |        |

**GENERAL NOTES**

SEED MIXTURE: SHALL NOT HAVE A WEED CONTENT EXCEEDING 0.40% BY WEIGHT AND SHALL BE FREE OF ALL NOXIOUS SEED.

SEED: TO BE APPLIED PER SEEDING FORMULAS OR AS DIRECTED BY THE RESIDENT ENGINEER.

FERTILIZER: FORMULA 10-20-10 TO BE USED WITH SEED APPLIED AT THE RATE OF 500 LBS./ACRE (HYDRO SEEDERS MAY USE 19-19-19 FORMULA).

AGRICULTURAL LIMESTONE: TO BE APPLIED AT THE RATE OF 2 TONS/ACRE OR AS DIRECTED BY THE RESIDENT ENGINEER.

TEMPORARY EROSION MATTING: TO BE PLACED ON EARTH SLOPES AS SHOWN ON THE PLANS, OR AS DIRECTED BY THE RESIDENT ENGINEER.

TOPSOIL: TO BE USED WITH SEED AS INDICATED ON THE PLANS OR AS DIRECTED BY THE RESIDENT ENGINEER.

**PROJECT TYPICAL SECTIONS**

PROJECT NAME: WALLINGFORD  
PROJECT NUMBER: STP ST WALK(I4)

FILE NAME: \$FILES\$  
PROJECT MANAGER: SUSAN SCRIBNER  
DESIGNED BY: L. HARDEN  
BRIDGE DESIGN SUPERVISOR: P. HALSTEAD

PLOT DATE: 1/9/2009  
DRAWN BY: W. WEATHERBY  
CHECKED BY: P. HALSTEAD  
SHEET 5 OF 26

**CHA**



