
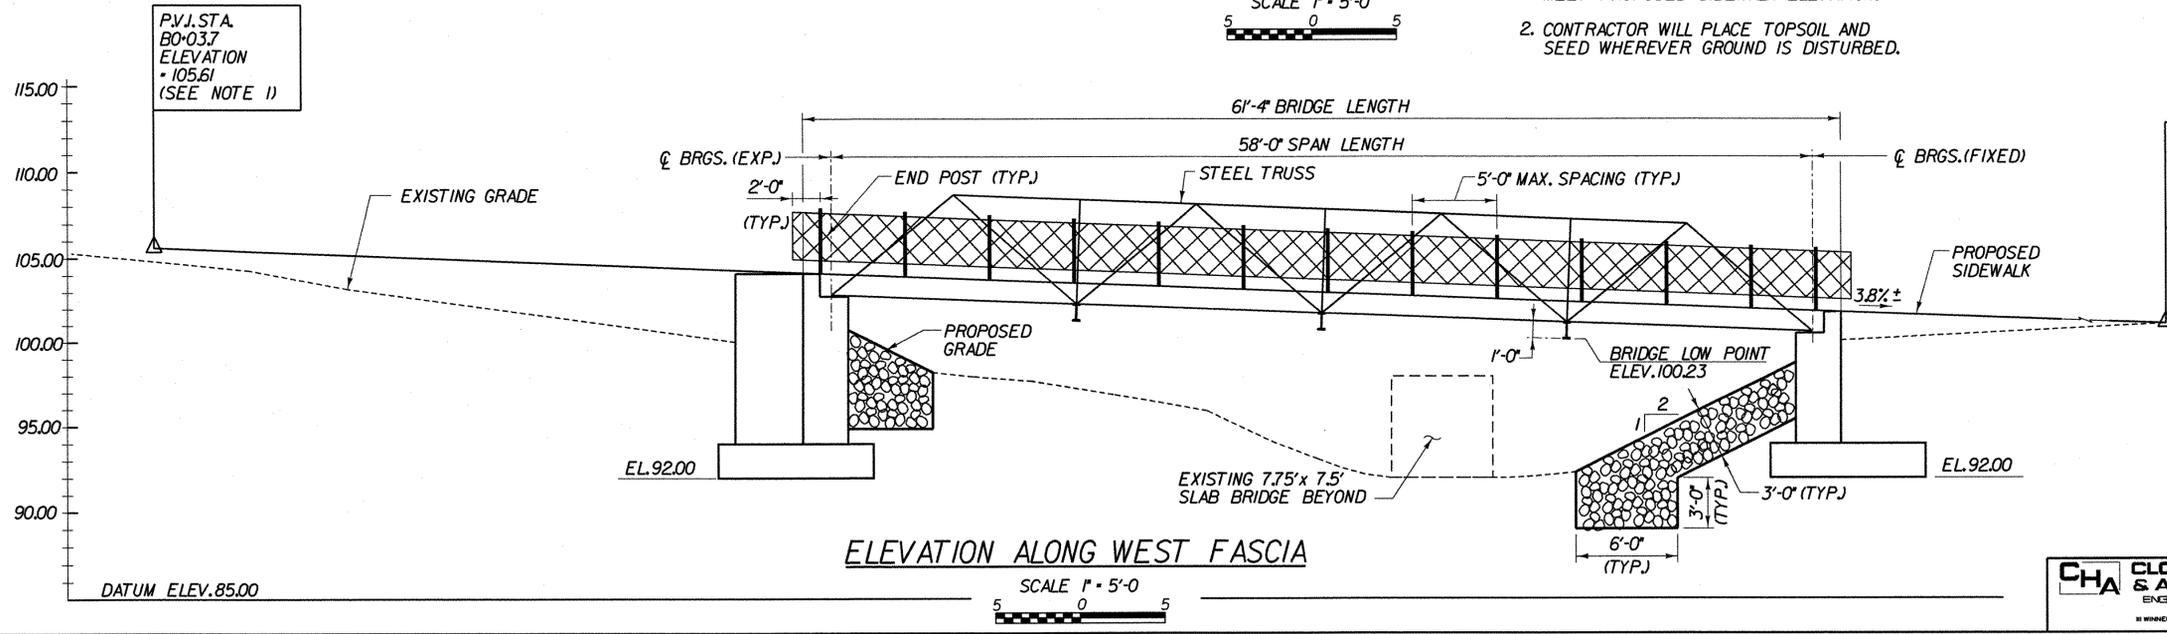


PLAN
SCALE 1" = 5'-0"

- NOTES:
 1. MEET PROPOSED SIDEWALK ELEVATION.
 2. CONTRACTOR WILL PLACE TOPSOIL AND SEED WHEREVER GROUND IS DISTURBED.

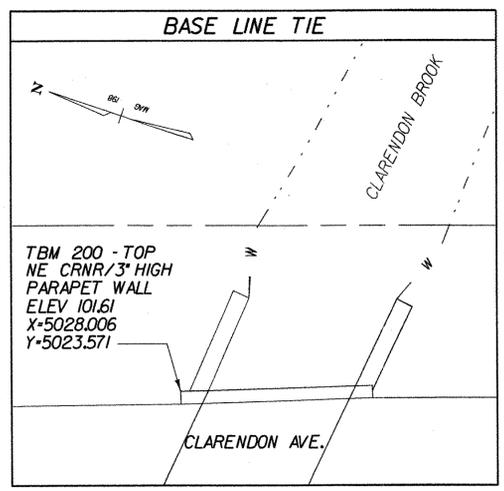

ELEVATION ALONG WEST FASCIA
SCALE 1" = 5'-0"

**STATE OF VERMONT
AGENCY OF TRANSPORTATION**

Town Of	WEST RUTLAND	Bridge No.	xx
Highway No.	CLARENDON AVE.	Log Sta.	
		Surv. Sta.	

PEDESTRIAN BRIDGE OVER CLARENDON BROOK

DESIGNED BY L. HARDEN		DRAWN BY Wm WEATHERBY	
CHECKED BY M. OLSTAD	DATE 4/2002	BRIDGE DESIGN SUPERVISOR M. OLSTAD	DATE 4/2002

PROJECT	WEST RUTLAND	PROJECT NO.	ST WALK (III)
---------	--------------	-------------	---------------

CHA CLOUGH, HARBOUR & ASSOCIATES LLP
 ENGINEERS, SURVEYORS, PLANNERS & LANDSCAPE ARCHITECTS
 WINNERS CIRCLE ALBANY, NEW YORK 12205

FILE NAME: s:\18224\18224\18224\FLEL.PLT
 DATE/TIME: 11/01/02
 USER: z461