


PLAN


SCALE 1/2" = 1'-0"
1 0 1 2

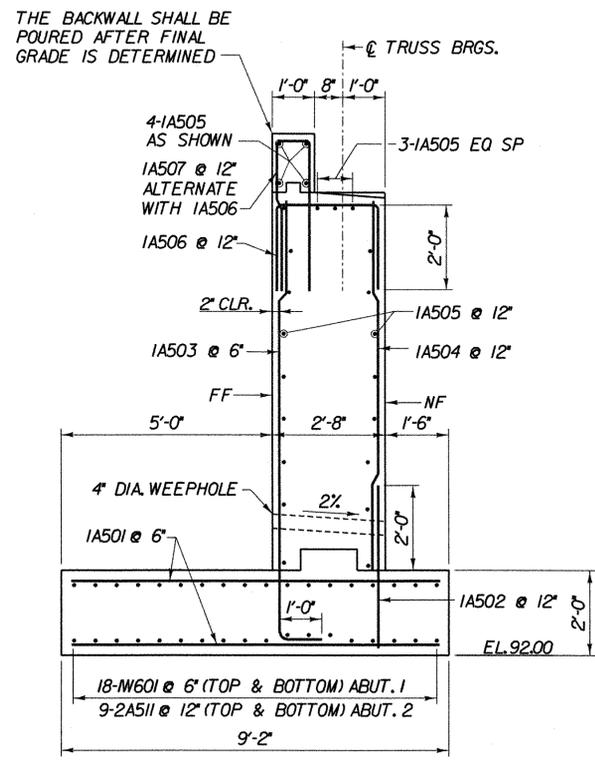

A TYPICAL ABUTMENT SECTION


ABUTMENT 1 (SHOWN), ABUTMENT 2 (SIMILAR, EXCEPT AS NOTED)

SCALE 1/2" = 1'-0"
1 0 1 2

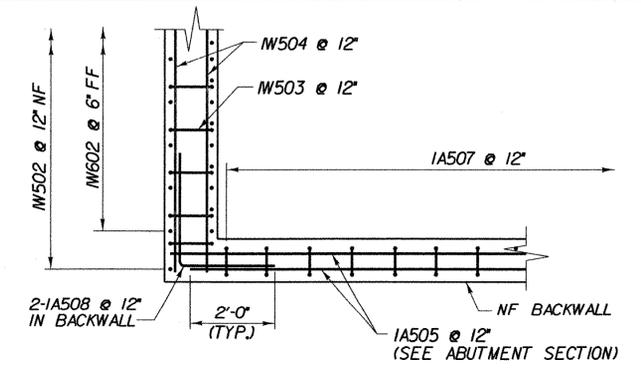

PLAN - BACKWALL CORNER - ABUTMENT 1

SCALE 1/2" = 1'-0"
1 0 1 2

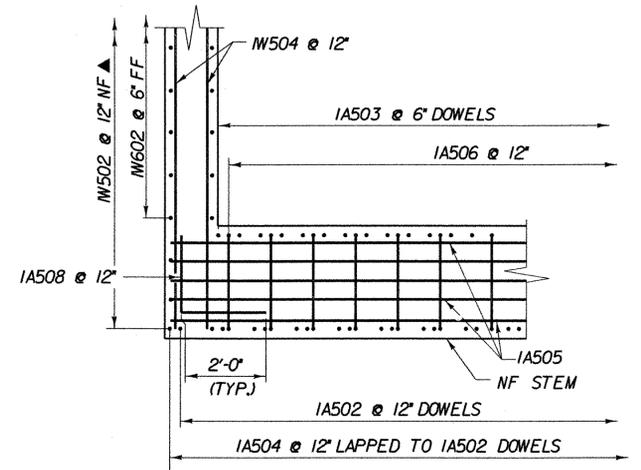


PLAN - STEM CORNER

SCALE 1/2" = 1'-0"
1 0 1 2


NOTE:

- NF - NEAR FACE
- FF - FAR FACE
- EF - EACH FACE
- 3" CLR. UNLESS OTHERWISE SPECIFIED ON THE PLANS.
- ▲ - CUT TO FIT IN FIELD

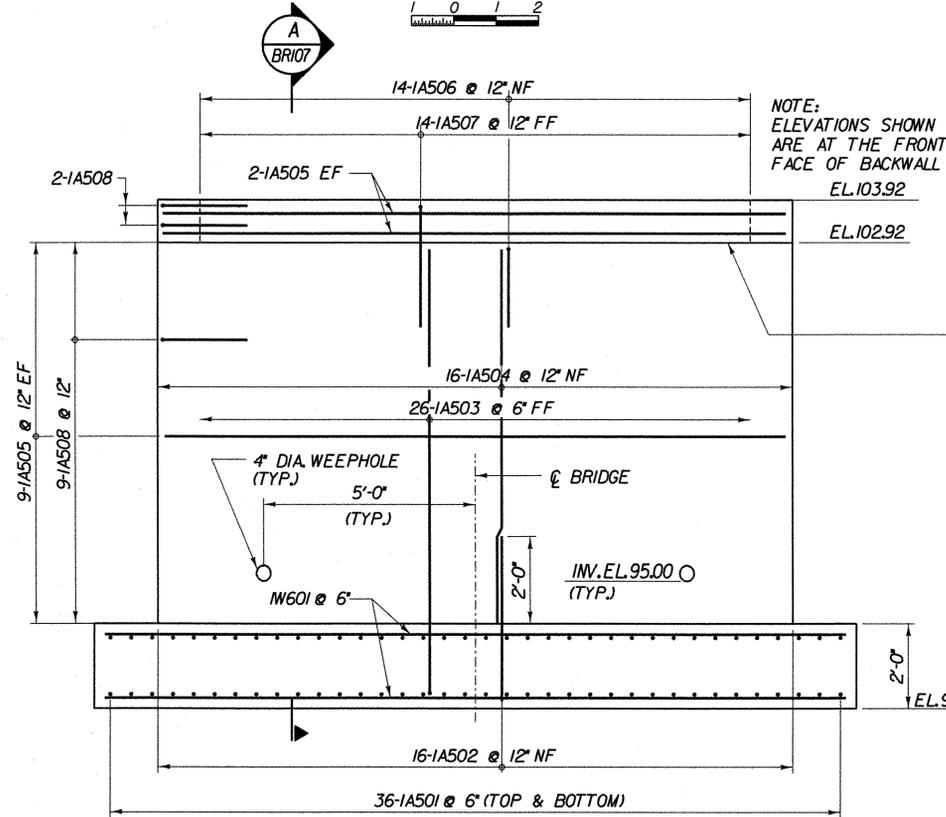

ELEVATION ABUTMENT 1


SCALE 1/2" = 1'-0"
1 0 1 2

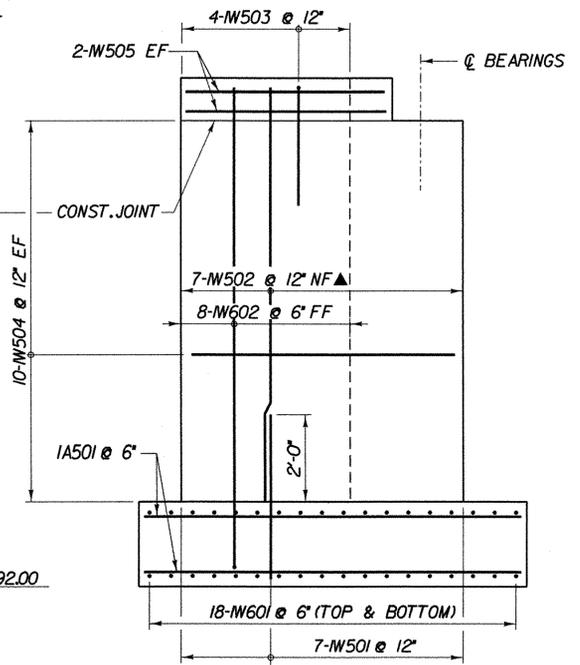

ABUTMENT 1 WINGWALL REINF. ELEVATION

EAST WINGWALL (SHOWN), WEST WINGWALL (SIMILAR)

SCALE 1/2" = 1'-0"
1 0 1 2

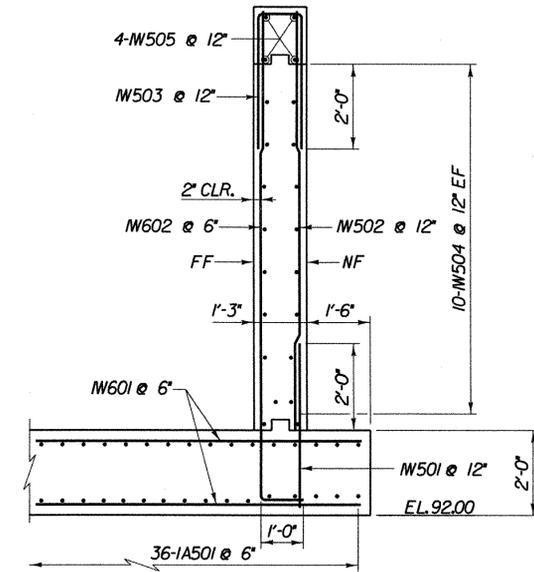

B TYPICAL ABUTMENT 1 WINGWALL SECTION

SCALE 1/2" = 1'-0"
1 0 1 2

STATE OF VERMONT AGENCY OF TRANSPORTATION		
Town Of	WEST RUTLAND	Bridge No. XX
Highway No.	CLARENDON AVE.	Log Sta.
		Surv. Sta.
PEDESTRIAN BRIDGE OVER CLARENDON BROOK ABUTMENT I PLAN AND ELEVATION		
Designed By	L. HARDEN	Drawn by Wm WEATHERBY
Checked By	M. OLSTAD	Bridge Design Supervisor
Date	4/2002	Date
PROJECT		PROJECT NO.
WEST RUTLAND		ST WALK (II)
I.G.C. Info.		
Bridge Sheet No. BRI07		Sheet 9 OF 12



FILE NAME: S:\10224\WSTN15\ABUT1.PLT DATE/TIME: 11/01/02 USER: z467