


PLAN
SCALE 1" = 5'-0"

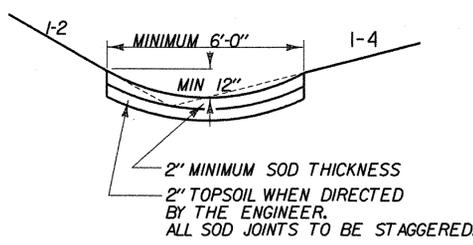

SODDING DETAIL
(NOT TO SCALE)

- LEGEND**
- HAY BALES FOR EROSION CONTROL, ITEM 651.26
 - GEOTEXTILE FOR SILT FENCE - ITEM 649.51

STATE OF VERMONT AGENCY OF TRANSPORTATION			
Town Of	WEST RUTLAND	Bridge No.	XX
Highway No.	CLARENDON AVE.	Log Sta.	
		Surv. Sta.	
PEDESTRIAN BRIDGE OVER CLARENDON BROOK DRAINAGE & TEMPORARY EROSIAN CONTROL			
Designed By	L. HARDEN	Drawn by	Wm WEATHERBY
Checked By	M. OLSTAD	Date	4/2002
		Bridge Design Supervisor	M. OLSTAD Date 4/2002
PROJECT	WEST RUTLAND	PROJECT NO.	ST WALK (II)
I.G.C. Info.			
Bridge Sheet No. BR110		Sheet 12 OF 12	

CHA CLOUGH, HARBOUR & ASSOCIATES LLP
ENGINEERS, SURVEYORS, PLANNERS & LANDSCAPE ARCHITECTS
WINNERS CIRCLE ALBANY, NEW YORK, 12205

FILE NAME: \\10224\MSTIN\1510224\DRN_PLAN.dwg
DATE/TIME: 11/01/02
USER: 2467