




2 PLAN
SCALE: 1/4"=1'-0"

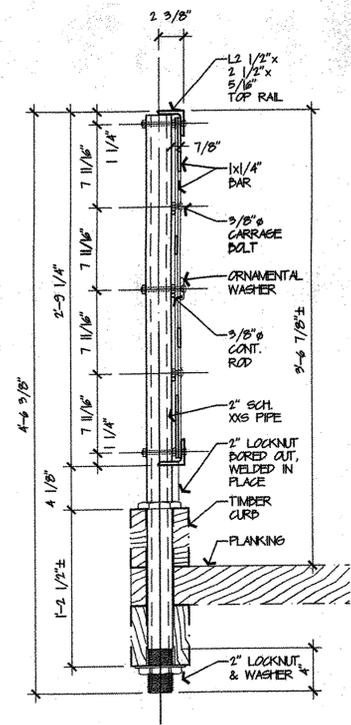

3 SECTION
SCALE: 1 1/2"=1'-0"

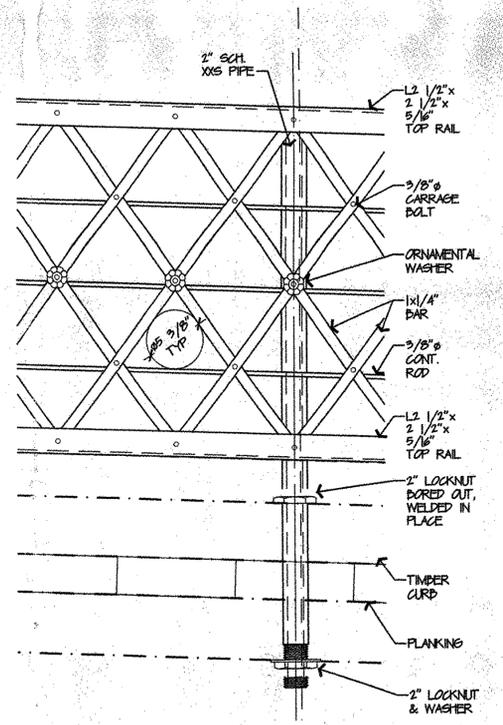

4 ELEV. DETAIL
SCALE: 1 1/2"=1'-0"

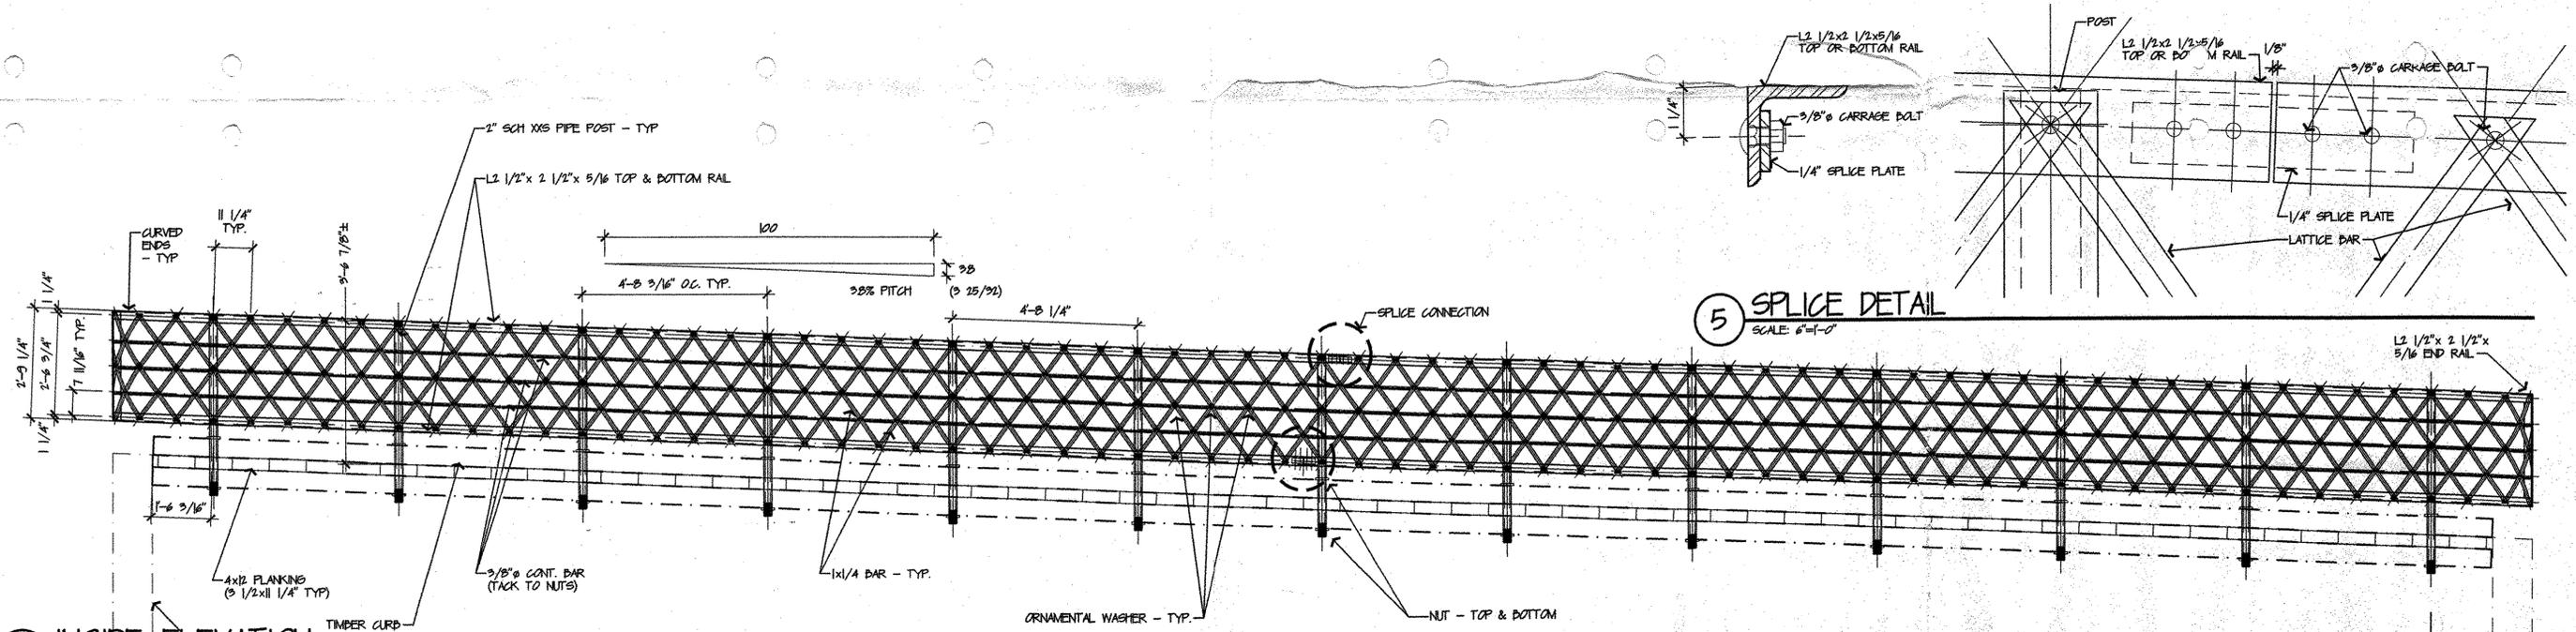

1 INSIDE ELEVATION
SCALE: 1/4"=1'-0"

5 SPLICE DETAIL
SCALE: 6"=1'-0"

NO EXCEPTION TAKEN
 REJECTED
 SUBMIT SPECIFIED ITEM

MAKE CORRECTIONS NOTED
 REVISE AND RESUBMIT

CHECKING IS ONLY FOR GENERAL CONFORMANCE WITH THE DESIGN CONCEPT OF THE PROJECT AND GENERAL COMPLIANCE WITH THE INFORMATION GIVEN IN THE CONTRACT DOCUMENTS. ANY ACTION SHOULD BE TAKEN TO THE REQUIREMENTS OF THE PLANS AND SPECIFICATIONS. CONTRACTOR IS RESPONSIBLE FOR VERIFYING WHICH SHALL BE COMPARED AND COORDINATED AT THE JOB SITE. FABRICATOR, WELDER AND TACKWELDER, BY CONSTRUCTION COORDINATOR ON THE WORK WITH TALK OF ALL OTHER TRADES AND THE SATISFACTORY PERFORMANCE OF THE WORK.

CLOUGH HARBOUR & ASSOCIATES LLP
 ARCHITECTS, ENGINEERS, PLANNERS
 8/25/03 BY [Signature]

RECEIVED
 OK'D BY [Signature] OK'D BY [Signature]
 AUG 14 2003
 RESUBMIT APPROVED WITH CHANGES
 BY [Signature] DATE 8/26/03 NOTED IN RED

NOTE:
 1. RAILINGS TO RECEIVE PRIME & TOP COAT AS PER VAT. SUP. SPEC # 919 PRIOR TO ASSEMBLY

REVISIONS		REMARKS	
DATE	7/31/03	PROJECT	WEST RUTLAND ST WALK (11)
DRAWN BY	CCE	LOCATION	PEDESTRIAN BRIDGE OVER CLARENDON BROOK
CHECK'D BY		CUSTOMER	STATE OF VERMONT, AGENCY OF TRANSPORTATION
HOLES	A325	ARCHITECT	CLOUGH HARBOUR & ASSOC. LLP
PAIN	AS NOTED	JOB NO.	RFC 598
SCALE		SHEET NAME	INSIDE ELEVATION & PLAN, RAILING
		PHONE #	(810) 798-3533
		FAX #	(810) 798-1711
		RIVERSIDE FAB, INC.	
		PRINT RECORD	
DATE	NO.	DATE	NO.
		DRAWING NUMBER	E1