


PROFILE

SCALE: 1" = 20' HORIZONTAL
1" = 10' VERTICAL

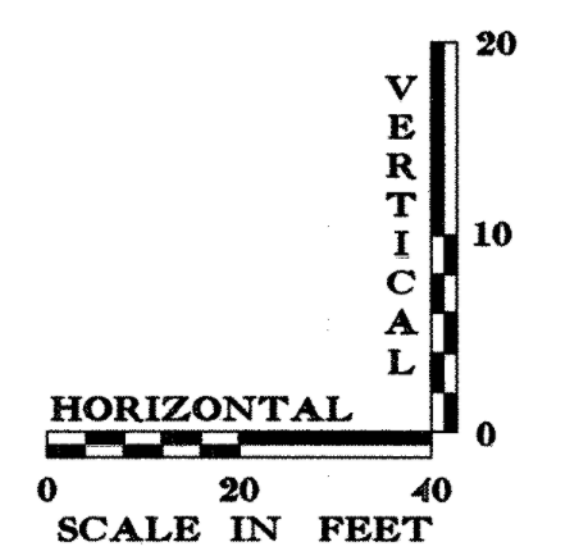

DATUM	
VERTICAL	NGVD 1929
HORIZONTAL	NAD 83

URS URS CORPORATION 28 CORPORATE DRIVE, SUITE 200 CLIFTON PARK, NY 12065 PH# (518) 688-0015	SHEET NAME: PROFILE
	PROJECT NAME: SWANTON
	PROJECT NUMBER: STP ST MHTB(I)
	FILE NAME: zf024prol.dgn
	PLOT DATE: 2/13/2008
	DRAWN BY: R. ROSS
	CHECKED BY: M. K. CHEVALIER
	SHEET 7 OF 63