


NOTES

1. PROPERTY LINES & ROW LINE ARE APPROXIMATE AND BASED ON A MAP OF BOUNDARY SURVEY PERFORMED BY BUCK & PIERCE CONSULTING ENGINEERS IN JULY, 1983.
2. STORM CONVEYANCE IS BY SHEET FLOW.

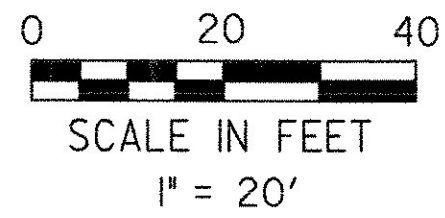

LEGEND	
	LIMIT OF WETLANDS

DATUM	
VERTICAL	NGVD 1929
HORIZONTAL	NAD 83

SHEET NAME: EXISTING CONDITIONS SITE PLAN	
PROJECT NAME: SWANTON	PROJECT NUMBER: STP ST MHTB(1)
FILE NAME: zf024xcspl.dgn	PLOT DATE: 2/13/2008
PROJECT LEADER: M. K. CHEVALIER	DRAWN BY: M. MCINTOSH
DESIGNED BY: B. ERNST	CHECKED BY: M. K. CHEVALIER
	SHEET 14 OF 63

URS
 URS CORPORATION
 28 CORPORATE DRIVE, SUITE 200
 CLIFTON PARK, NY 12065
 PH# (518) 688-0015